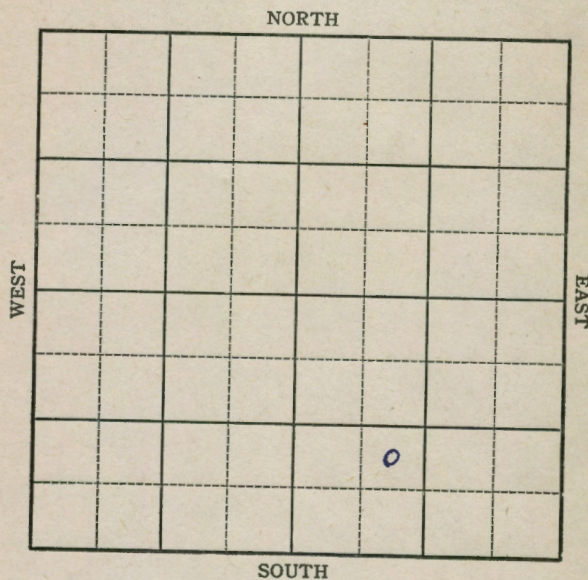


KANSAS

FORM 51-5M PETROL

Cowley

Section 14 Township 34 Range 5-EWell No. #2 Ruth RahnCompany Ben GralappFORM 252-A
5M 9-43 GASS

KANSAS


Cowley

Sec. 14 Twp. 34 R. 5-EWell No. #2 Ruth Rahn FarmBen Gralapp Company

_____ Ft. from N. Line

990 Ft. from S. Line

_____ Ft. from E. Line

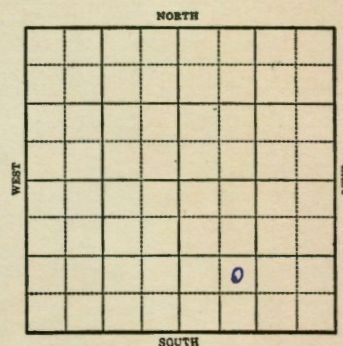990 Ft. from W. LineElev. 1142

1943

REPORT

10/13 Location

10/20 "

10/27 "

11/3 "

11/10 "

11/17 8" @ 107'
Drlg. 1740'

11/24 Drlg 2870'

12/1 **Bart 2955**
5" @ 2955'

TD 2995 flow 40 oil 2/3 hrs

12/8 509 2972-95

12-15 Pump 300 oil

12/22 " " "

12/29 " "

1944 " "

1-5 " "

1/12 5" @ 2955

Bart 2955

TD 2995

50 qts 2972-95

Flowed Pot 259 Pot.

Gravity 36.7

COMPLETED

KANSAS

Map No. 2 Sec. 14 Twp. 34 R. 5EWell No. 2 Ruth RahnBen Gralapp

Company

COMPLETED

Contractor

NE SW SE

SECTION PLAT

Ft. from N. Line

990

Ft. from S. Line

Ft. from E. Line

990

Ft. from W. Line

Miscellaneous

Location

Rig up

Drilling and Remarks:

Bar 29555" @ 2955509 to 2952-95Flow 2957-95362 lb

RECORD

Cased in. ft.

Sand

Gas

Oil

Total Depth 2995

PRODUCTION

1st 24 hrs. Nat.

1st 24 hrs. after shot

Gas

Cu. Ft.

Dry Hole

Abandoned

Date

JAN 12 1944

19

S. J. LEWIS

Scout

KANSAS

Map No. 2 Sec. 14 Twp. 34 R. 5EWell No. 2 Ruth RahnBen Gralapp

Company

FIRST REPORT

Contractor

NE SW SE

SECTION PLAT

Ft. from N. Line

990

Ft. from S. Line

Ft. from E. Line

990

Ft. from W. Line

Miscellaneous

Location X

Rig up

Drilling and Remarks:

RECORD

Cased in. ft.

Sand

Gas

Oil

Total Depth

PRODUCTION

1st 24 hrs. Nat.

1st 24 hrs. after shot

Gas

Cu. Ft.

Dry Hole

Abandoned

Date

OCT 13 1943

19

S. J. LEWIS

Scout