


KANSAS

Cowley

Section 22 Township 34 Range 5E
 Well No. #1 J. Devore "A"
 Company Continental

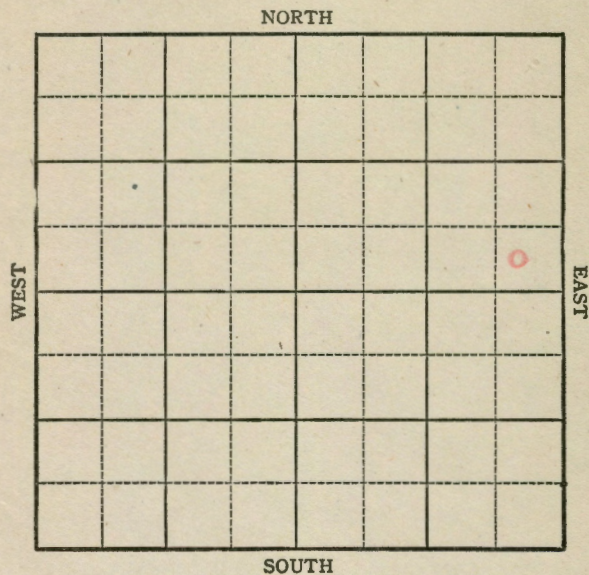


KANSAS

Cowley

Sec. 22 Twp. 34 R. 5E
 Well No. #1 J. Devore "A" Farm _____
Continental Company _____

Miscellaneous

_____ Ft. from N. Line
410 Ft. from S. Line
410 Ft. from E. Line
 _____ Ft. from W. Line

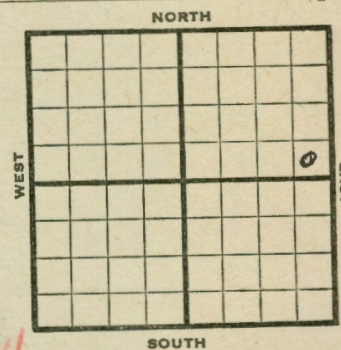SE NE Edw. 1094

1945

REPORT

2/14	Location
2/21	"
2/28	"
3/7	"
3/14	10" @ 200 Drlg 1520
3/23	Bart 2944 TD 2958 Sat. 6" @ 2944' RUST
3/29	" " " "
4/5	TD 2968 20 qts. 2956-66 2500' oil
4/12	" " " " " "
4/20	Swb 53 oil plus 13 W in 8 hrs.
4/27	" " " " " "
5/9	Bart 2944 6" @ 2944 TD 2968 Pump 129 Pot. Grav. 39.0

COMPLETED

Kansas Pool Name MiscellaneousMap No. 2 Sec. 22 Twp. 34 R. 5EWell No. 1 J. Devore "A"Continental CompanyCOMPLETED

Contractor

SE NE

E 11094
SECTION PLAT

Ft. from N. Line

410 Ft. from S. Line410 Ft. from E. Line

Ft. from W. Line

Cowley County

Location

Rig up

Drilling and Remarks:

Bar 129446" @ 2944Pump 1290039 3/4

RECORD

Cased _____ in. _____ ft.

Sand _____

Gas _____

Oil _____

Total Depth 2765

PRODUCTION

1st 24 hrs. Nat. _____

1st 24 hrs. after shot _____

Gas _____ Cu. Ft.

Dry Hole _____

Abandoned _____

Date

MAY 9 1945 19S. J. LEWIS

Scout

Pool Name MiscellaneousMap No. K-2 Sec. 22 Twp. 34 R. 5EWell No. 1 J. Devore "A"Continental CompanyFIRST REPORT

Contractor

SE NE

SECTION PLAT

Ft. from N. Line

410 Ft. from S. Line410 Ft. from E. Line

Ft. from W. Line

CowleyLocation X

Rig up

Drilling and Remarks:

RECORD

Cased _____ in. _____ ft.

Sand _____

Gas _____

Oil _____

Total Depth _____

PRODUCTION

1st 24 hrs. Nat. _____

1st 24 hrs. after shot _____

Gas _____ Cu. Ft.

Dry Hole _____

Abandoned _____

Date

FEB 14 1945 19S. J. LEWIS

Scout