


Section 14 Township 34 Range 5-E
 Well No. #1 H. Waldschmidt
 Company Jock Garden et al

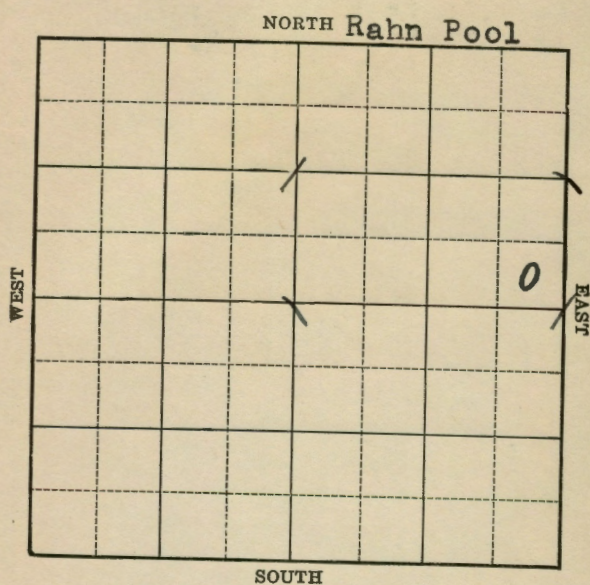

Sec. 14 Twp. 34 R. 5-E
 Well No. #1 H. Waldschmidt Farm
Jock Garden et al Company


(Rahn)

Ft. from N. Line

330 Ft. from S. Line330 Ft. from E. Line

Ft. from W. Line

Elev. 1098 Est DF
 1095 GR

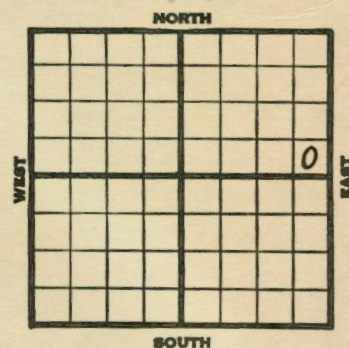

1940

REPORT

2/7

Cellar.

2/15

"

2/23

"

2/29

"

3/8

"

3/14

"

3/21

"

3/28

"

4/4

"

4/12

"

4/18

"

4/25

"

5/2

"

5/9

"

5/16

"

5/23

"

5/29

Derrick.

6/6

12" - 50' Drlg. 1070'

6/13

Drlg. 2916'

OVER

1940
6/19

No Bart.

T.D. 2982'

ABANDONED

Cowley

KANSAS

Map No. 2 Sec. 14 Twp. 34 R. 5EWell No. 1 H. Waldschmidt

Jock Garden etal

Company

Contractor

FIRST REPORT

SE NE

Ft. from N. Line

330 Ft. from S. Line330 Ft. from E. Line

Ft. from W. Line

RAHN POOL

SECTION PLAT

Location

Rig up

Drilling and Remarks:

Cellar

RECORD

Cased in., ft.

Sand

Gas

Oil

Total Depth

PRODUCTION

1st 24 hrs. Nat.

1st 24 hrs. after shot

Gas Cu. Ft.

Dry Hole

Abandoned

Date

FEB 7 1940 19

S. J. LEWIS

Scout

KANSAS

Map No. 2 Sec. 14 Twp. 34 R. 5EWell No. 1 H. Waldschmidt

Jock Garden etal

Company

Contractor

ABANDONED

SE NE

Ft. from N. Line

330 Ft. from S. Line330 Ft. from E. Line

Ft. from W. Line

RAHN POOL

SECTION PLAT

Location

Rig up

Drilling and Remarks:

No Bar V.

RECORD

Cased in., ft.

Sand

Gas

Oil

Total Depth 282

PRODUCTION

1st 24 hrs. Nat.

1st 24 hrs. after shot

Gas Cu. Ft.

Dry Hole

Abandoned

Date

JUN 19 1940 19

S. J. LEWIS

Scout