


KANSAS

Cowley

FORM 51 5M PETROL

Section 14 Township 34 Range 5E
 Well No. 1 H. Waldschmidt
 Company Ben Gralapp et al

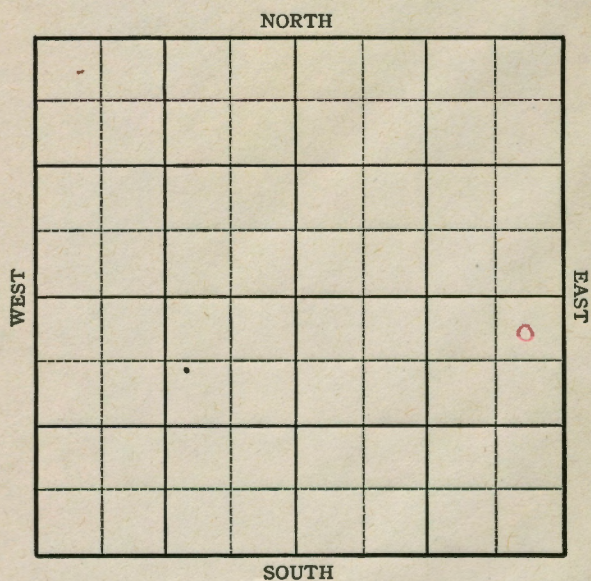


5M 3-45 PETROL

KANSAS

Cowley

Sec. 14 Twp. 34 R. 5-E
 Well No. #1 H. Waldschmidt Farm
Ben Gralapp et al Company

330 Ft. from N. Line
 _____ Ft. from S. Line
330 Ft. from E. Line
 _____ Ft. from W. Line

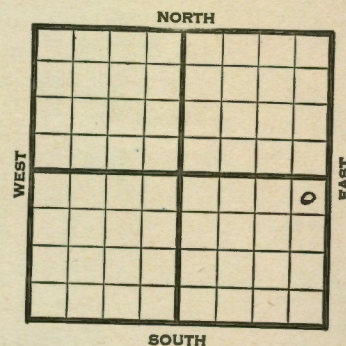

NE SE Elev. 1099

1945 REPORT

8/29 Drlg. 75'
 9/5 8" @ 87
 Drlg. 419'
 9/12 Drlg. 2070
 9/19 **Bart 2910**
 5" @ 2910
 TD 2930 RUST
 9/26 TD 2962
 10/3 70 qts. 2924-2952
 Flow 35 oil 1 hr.
 10/10 **Bart 2910**
 5" @ 2910
 70 qts. 2924-2954
 TD 2962'
 Flow 318 Pot.
 Grav. 38.0

COMPLETED

KANSASKansas Pool Name MiscellaneousMap No. 2 Sec. 14 Twp. 34 R. 5EWell No. 1 H. WaldschmidtBen Gralapp et al CompanyCOMPLETE

Contractor

E. 10 99
SECTION PLAT

NE SE

330 Ft. from N. Line Ft. from S. Line330 Ft. from E. Line Ft. from W. Line

Cowley County

Location

RECORD

Cased in., ft.Sand Gas Oil Total Depth 2762

PRODUCTION

1st 24 hrs. Nat. 1st 24 hrs. after shot Gas Cu. Ft.Dry Hole Abandoned

Date

OCT 10 1945 19S. J. LEWIS

Scout

KANSASKansas Pool Name MiscellaneousMap No. 2 Sec. 14 Twp. 34 R. 5EWell No. 1 H. WaldschmidtBen Gralapp et al CompanyFIRST REPORT

Contractor

NE SE

SECTION PLAT

330 Ft. from N. Line Ft. from S. Line330 Ft. from E. Line Ft. from W. Line

Cowley County

Location

RECORD

Cased in., ft.Sand Gas Oil Total Depth

PRODUCTION

1st 24 hrs. Nat. 1st 24 hrs. after shot Gas Cu. Ft.Dry Hole Abandoned

Date

AUG 29 1945

19

S. J. LEWIS Scout