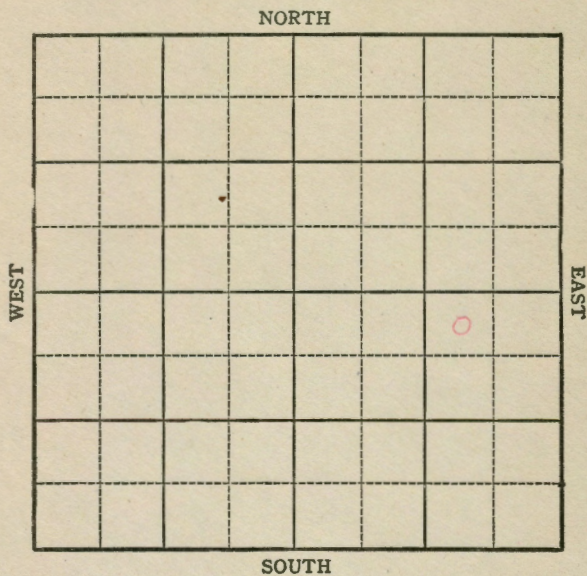


Cowley

KANSAS

Section 22 Township 34 Range 5EWell No. #1 HankinsCompany B. B. Blair

KANSAS

Cowley

Sec. 22 Twp. 34 R. 5EWell No. #1 Hankins Farm

B. B. Blair

Company

Miscellaneous


330 Ft. from N. Line

Ft. from S. Line

990 Ft. from E. Line

Ft. from W. Line

NW NE SE

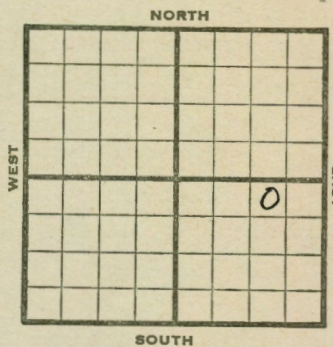

1944

REPORT

12/20

Rotary

12/29

8" @ 538 Drlg. 775'

1945

1/3

Drlg 2610

1/10

Bart 2944

TD 2959

5" @ 2944 RUST

1/17

TD 2960½ VSSO SD

1/26

TD 2962

20 qts 2954-2962

Flow 100 oil

1/31

" " " "

2/7

" " " "

2/14

Bart 2944

5" @ 2944

20 qts 2954-2962

Pump 23 Pot.

TD 2962

Grav. 38.0

COMPLETED

Pool Name MiscellaneousMap No. K-2 Sec. 22 Twp. 34 R. 5EWell No. 1 HankinsB. B. Blair CompanyCOMPLETED Contractor

NW NE SE

SECTION PLAT

330 Ft. from N. Line

Ft. from S. Line

990 Ft. from E. Line

Ft. from W. Line

			0

Cowley

Location

Rig up

Drilling and Remarks:

Bar 29445" @ 2944209 to 2954-62Punch 28 BX38-6

RECORD

Cased in. ft.

Sand

Gas

Oil

Total Depth 2962

PRODUCTION

1st 24 hrs. Nat.

1st 24 hrs. after shot

Gas Cu. Ft.

Dry Hole

Abandoned

Date

FEB 14 1945 19S. J. LEWIS ScoutPool Name MiscellaneousMap No. 2 Sec. 22 Twp. 34 R. 5EWell No. 1 HankinsB. B. Blair CompanyFIRST REPORT

Contractor

NW NE SE

SECTION PLAT

330 Ft. from N. Line

Ft. from S. Line

990 Ft. from E. Line

Ft. from W. Line

			0

Cowley

Location

Rig up

Drilling and Remarks:

rotary

RECORD

Cased in. ft.

Sand

Gas

Oil

Total Depth

PRODUCTION

1st 24 hrs. Nat.

1st 24 hrs. after shot

Gas Cu. Ft.

Dry Hole

Abandoned

Date

DEC 20 1944 19S. J. LEWIS Scout