


Cowley

Section 22 Township 34 Range 5E

Well No. #1 J.C. Hankins

Company Gralapp etal.

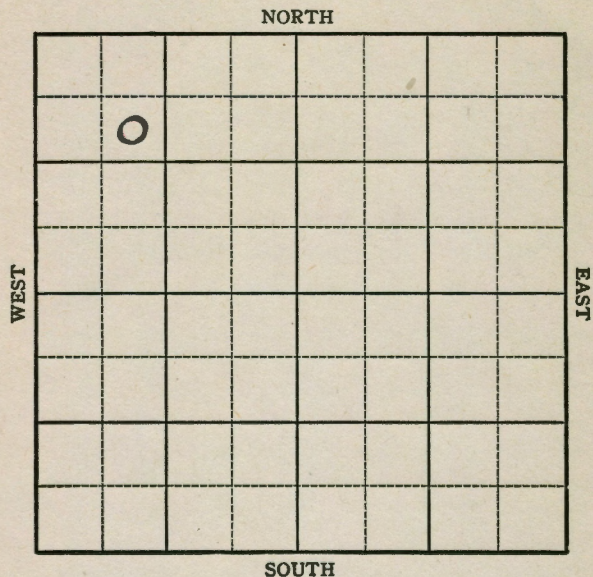

Cowley

Sec. 22 Twp. 34 R. 5E

Well No. #1 J.C. Hankins Farn

Gralapp etal. Compan


Miscellaneous

990 Ft. from N. Line

 Ft. from S. Line

 Ft. from E. Line

990 Ft. from W. Line

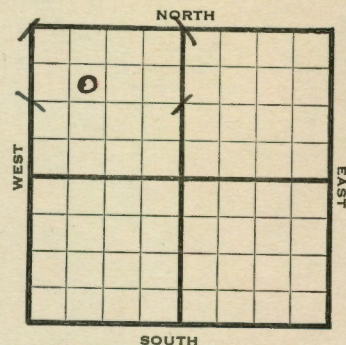

1944

REPORT

4/12 Location

4/19 Surface hole

4/26 SD

5/3 Bart 2995

Miss 3069

Drlg. 3083'

5/9 Miss. 3069'

TD 3085'

ABANDONED

Pool Name Miscellan**KANSAS**Map No. 7 Sec. 22 Twp. 34 R. EWell No. 1 J. C. HankinsGralapp etal.

Comp

ABANDONED

Contract

SE NW NW

SECTION PLAT

990

Ft. from N. Line

Ft. from S. Line

Ft. from E. Line

990

Ft. from W. Line

0			

Cowley County

Location

Rig up

Drilling and Remarks:

Max 3068

RECORD

Cased in, ft.

Sand

Gas

Oil

Total Depth 3085

PRODUCTION

1st 24 hrs. Nat.

1st 24 hrs. after shot

Gas Cu. Ft.

Dry Hole

Abandoned

Date

MAY 10 1944

19

S. J. LEWIS

Scout

Cowley

KANSASMap No. 7 Sec. 22 Twp. 34 R. 5EWell No. 1 J. C. HankinsGralapp etal.

Company

FIRST REPORT

Contractor

SE NW NW

SECTION PLAT

990

Ft. from N. Line

Ft. from S. Line

Ft. from E. Line

990

Ft. from W. Line

0			

Miscellaneous

Location X

Rig up

Drilling and Remarks:

RECORD

Cased in, ft.

Sand

Gas

Oil

Total Depth

PRODUCTION

1st 24 hrs. Nat.

1st 24 hrs. after shot

Gas Cu. Ft.

Dry Hole

Abandoned

Date

APR 12 1944

19

S. J. LEWIS

Scout