

Cowley


KANSAS

Section 26 Township 34 Range 5 E

Well No. #1 Williamson

Company Art Holliday

NORTH

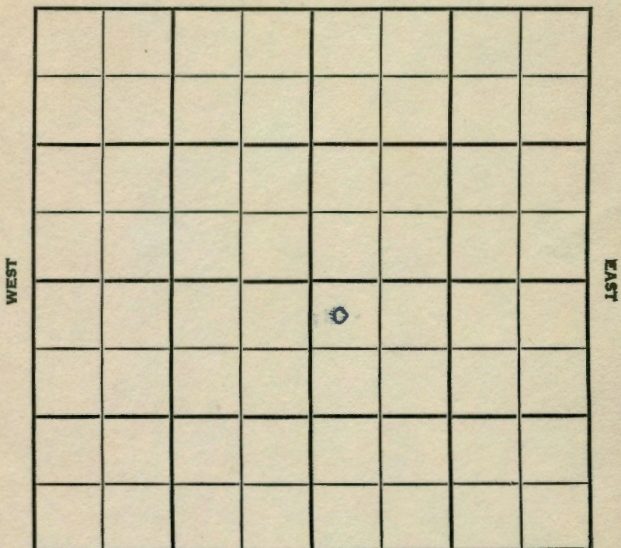

SOUTH

Cowley

KANSAS

SEC. 26	TWP. 34	R. 5E
---------	---------	-------

WELL NO. #1 Williamson

COMPANY Art Holliday FARM.

CONTRACTOR


Wildcat

\_\_\_\_\_ Ft. from N. Line

\_\_\_\_\_ Ft. from S. Line

\_\_\_\_\_ Ft. from E. Line

\_\_\_\_\_ Ft. from W. Line

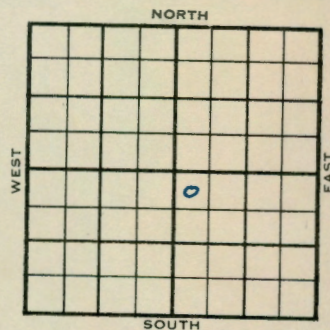

NW NW SE

1955	ELEVATION 1238'	REPORT
------	-----------------	--------

8/17 Location

9-7 COMM. 8-23-55  
 8 5/8" @ 120/75  
 DST 2795-2815, open 95 min., rec 17' so&gcm 0/20"  
 DST 2815-60, open 1 1/2 hr., rec 65' mud 0/30"  
 DST 3136-40, open 40 min., rec 15' mud 0/20"  
 D & A

Tops	Depth
Stal	2083
Layton	2307
Osw.	2731
M.	3127
Ch	3143
T.D.	3150'

ABANDONED

County **Cowley** Elev. \_\_\_\_\_  
 Sec. **26** Twp. **34** Rge. **5E**  
 Company **Art Holliday**  
 FarmName **Williamson** No. **1**

TOPS	DEPTH	LOG	DATUM	Loc. in Sec.
Anh.				NW NW SE
Tp.				
H.				
Tr.				
Dg.				
Bl.				
L.				Geol.
K.C.				Contr.
B.K.C.				
Ce.				
C.				
M.				Pool
M.				Wildcat
K.				
Mz.				
Me.				
V.				
S.				
S.				
A.				
R.				
Pf.				
G.				
T.D.				

FIRST REPORT  
 0  
 AUG 17 '55

Date Comm. \_\_\_\_\_  
 Location \_\_\_\_\_  
 \_\_\_\_\_  
 \_\_\_\_\_  
 \_\_\_\_\_  
 \_\_\_\_\_  
 \_\_\_\_\_  
 \_\_\_\_\_

County ~~Cowley~~ Elev. **1238**  
 Sec. ~~26~~ Twp. ~~34~~ Rge. ~~5E~~  
 Company ~~Art Holliday~~  
 FarmName ~~Williamson~~ No. ~~1~~

TOPS	DEPTH	LOG	DATUM	Loc. in Sec.
Anh. <i>Stal</i>	<i>2083</i>		<i>845</i>	NW NW SE
Tp. <i>Rayton</i>	<i>2317</i>		<i>1869</i>	
H. <i>Case</i>	<i>2734</i>		<i>1493</i>	
Tr.				
Dg.				
Bl.				
L.				Geol.
K.C.				Contr.
B.K.C.				
Ce.				
C.				
M.				Pool
M. <i>ch</i>	<i>3127</i>		<i>1889</i>	Wildcat
K.	<i>3143</i>		<i>1915</i>	
Mz.				
Me.				
V.				
S.				
S.				
A.				
R.				
Pf.				
G.				
T.D.	<i>3180</i>			

ABANDONED  
 0

Date Comm. **8-23-55** **SEP 7 1955**  
**8 5/8" @ 120/75 DST 2795-2815**  
**open 95 min. Rec. 17' so & g cm 0/30"**  
**DST 2815-60 open 1 1/2 hr. Rec. 65' mud**  
**0/30" DST 3136-40 open 40 min.**  
**Rec. 15' mud 0/20"**  
**D & A**