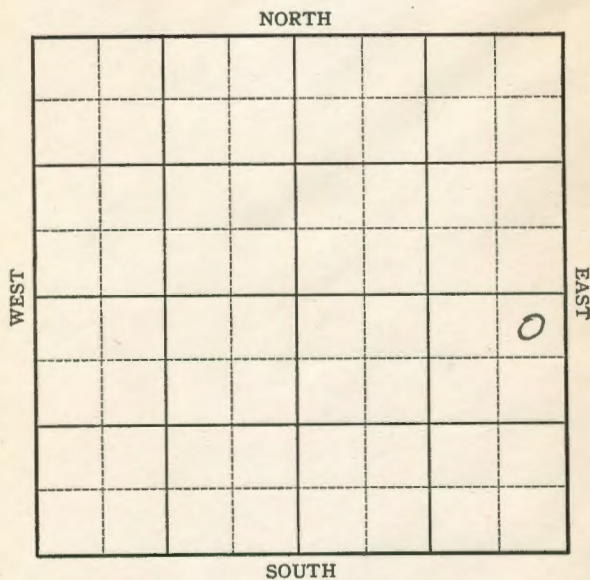


KANSAS

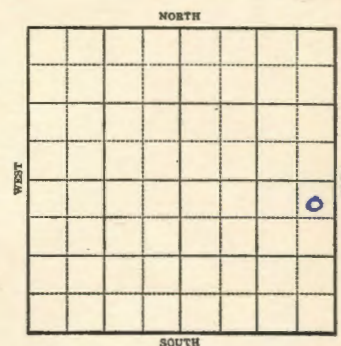
Cowley

FORM 51 5M 1-42 PETROL

Section 28 Township 34 Range 5-EWell No. #1 DunnCompany Gralapp etalFORM 252-A
5M 9-43 GASS

KANSAS

Cowley

Sec. 28 Twp. 34 R. 5-EWell No. #1 Dunn FarmGralapp etal Company330 Ft. from N. Line Ft. from S. Line330 Ft. from E. Line Ft. from W. Line

1943

REPORT

11/10 Rotary
 11/17 10" @ 117
 WOC
 11/24 Drlg 2190'
 12/1 Bart 2960-90 TD
 5" @ 2968
 RUST

12/8 " "

12-15 Barb 2976' Corrected
 5" at 2968'
 TD 3023'
 PB 3018'
 80 qts 2986'- 3017
 1500 fluid 50% oil

12/22 PB 3018
 Swb 7 oil & 15 water in 8 hrs.

12/29 3040 SD

1944

1-5 "

1-12 TD 3062- 6½ oil plus 6 w
 SD

1/19 TD 3070
 PB 3017

OVER

1944

1/26

5" @ 2968

Bart 2976

TD 3070

80 qts 2986@3018

PB 3017

Pump 10 oil & 20 Water

Gravity 38

COMPLETED

KANSAS

Cowley

Map No. 2 Sec. 28 Twp. 34 R. 5EWell No. 1 Dunn

Gralapp etal.

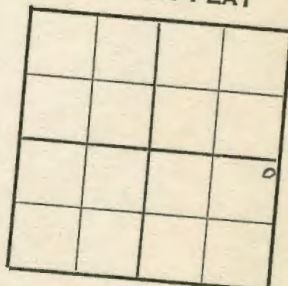
COMPLETE

Company

NE SE

Contractor

SECTION PLAT

330 Ft. from N. Line

Ft. from S. Line

330 Ft. from E. Line

Ft. from W. Line

Wildcat

Location

Rig up

Drilling and Remarks:

*Bar Y2976**5-102968**909 to 2986-3018**PA 3017**Pump 10 in. x 20 ft**352 ft*

RECORD

Cased _____ in. _____ ft.

Sand _____

Gas _____

Oil _____

Total Depth 3270

PRODUCTION

1st 24 hrs. Nat. _____

1st 24 hrs. after shot _____

Gas _____ Cu. Ft.

Dry Hole _____

Abandoned _____

Date

JAN 26 1941 19

S. J. LEWIS Scout

Cowley

KANSAS

Map No. 2 Sec. 28 Twp. 34 R. 5EWell No. 1 Dunn

Gralapp etal.

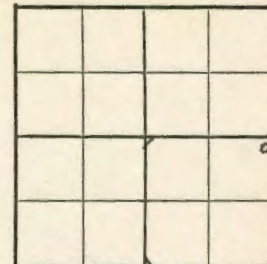
Company

FIRST REPORT

Contractor

NE SE

SECTION PLAT

330 Ft. from N. Line

Ft. from S. Line

330 Ft. from E. Line

Ft. from W. Line

Wildcat

Location

Rig up

Drilling and Remarks:

Rotary

RECORD

Cased _____ in. _____ ft.

Sand _____

Gas _____

Oil _____

Total Depth _____

PRODUCTION

1st 24 hrs. Nat. _____

1st 24 hrs. after shot _____

Gas _____ Cu. Ft.

Dry Hole _____

Abandoned _____

Date

NOV 10 1943 19

S. J. LEWIS Scout