

**KANSAS**

Cowley

Sec. 29 Twp. 34 R. 5E

Well No. #1 Fee Farm \_\_\_\_\_

C.M. Boggs etal Company \_\_\_\_\_


Miscellaneous

\_\_\_\_\_ Ft. from N. Line

330 Ft. from S. Line

990 Ft. from E. Line

\_\_\_\_\_ Ft. from W. Line

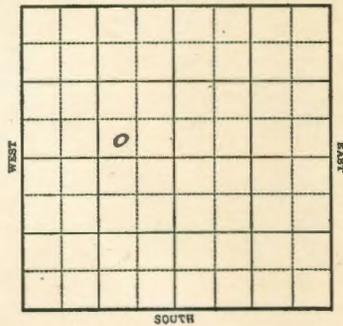

1944

REPORT

2/23 Derrick  
 3/1 10" @ 70  
 Drlg. 1938

3/8 **Lans 2399**  
**KC 2601**  
**BKC 2876**  
**Bart 3095**  
**B. Bart 3113**  
**SSO**

3/15 **Miss. 3170**  
**TD 3175**

**ABANDONED**


**O.W.W.O.**

Cowley

Section 29 Township 34 Range 5E

Well No. #1 Fee *Boggs*

Company C.M. Boggs etal

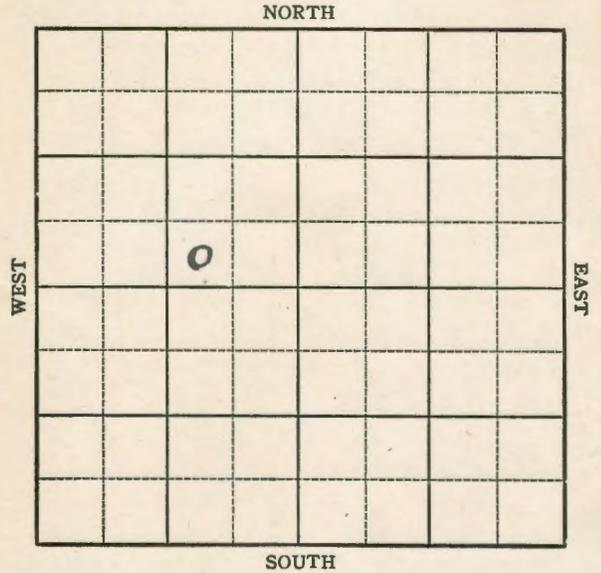

O.W.W.O.

S-513-A

CO. Cowley ELEV. FIRST REPORT  
SEC. 29 TWP. 34 RGE. 5E  
COMPANY C. M. Boggs NO. 1

FARM Boggs (O.W.W.O.)  
LOC. SW SE NW 1/2 Mi W. of Quarry

GEOL. O.W.W.O.  
CONTR.  
POOL  
SPUD  
OLD INFO: Lans. 2399,  
KC 2601, BKC 2876,  
Btvl Sd 3095, Miss  
3170, OTD 3175, D & A  
NEW INFO: Watson Drlg.  
Tools, CO 2809 E-Log  
Clev. Sd. 2710-53, 5" @ 2809.

CO.  
TWP.  
RGE.  
SEC.  
NO.  
TWP.  
RGE.

O.W.W.O.

S-513-A

CO. Cowley ELEV. ABANDONED  
SEC. 29 TWP. 34 RGE. 5E  
COMPANY C. M. Boggs NO. 1  
DEC 26 '57

FARM Boggs (O.W.W.O.)  
LOC. SW SE NW 1/2 Mi W. of Quarry

GEOL.  
CONTR.  
POOL  
SPUD  
OLD INFO: Lans. 2399,  
KC 2601, BKC 2876,  
Btvl Sd 3095, Miss  
3170, OTD 3175, D & A  
NEW INFO: Watson Drlg.  
Tools, CO 2809 E-Log  
Clev. Sd. 2710-53, 5" @ 2809.

Co 40/2708-19 332 108upl  
Deck 59  
DEC 18 '57 DEC 26 '57  
Loss 10

D & A

Map No. 2 Sec. 29 Twp. 34 R. 5E

Well No. 1 Fee

C. M. Boggs et al. Company

FIRST REPORT Contractor

SW SE NW


SECTION PLAT

\_\_\_\_\_ Ft. from N. Line

330 Ft. from S. Line

990 Ft. from E. Line

\_\_\_\_\_ Ft. from W. Line

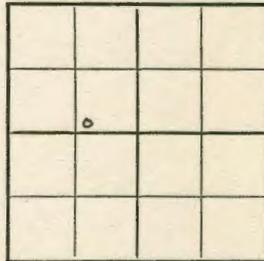

Miscellaneous

Location \_\_\_\_\_

Rig up \_\_\_\_\_

Drilling and Remarks:  
Derrick

RECORD

Cased \_\_\_\_\_ in., \_\_\_\_\_ ft.

Sand \_\_\_\_\_

Gas \_\_\_\_\_

Oil \_\_\_\_\_

Total Depth \_\_\_\_\_

PRODUCTION

1st 24 hrs. Nat. \_\_\_\_\_

1st 24 hrs. after shot \_\_\_\_\_

Gas \_\_\_\_\_ Cu. Ft.

Dry Hole \_\_\_\_\_

Abandoned \_\_\_\_\_

Date

FEB 23 1944 19

S. J. LEWIS Scout

**KANSAS**  
Map No. 2 Sec. 29 Twp. 34 R. 5E

Well No. 1 Fee

C. M. Boggs et al. Company

ABANDONED Contractor

SW SE NW


SECTION PLAT

\_\_\_\_\_ Ft. from N. Line

330 Ft. from S. Line

990 Ft. from E. Line

\_\_\_\_\_ Ft. from W. Line

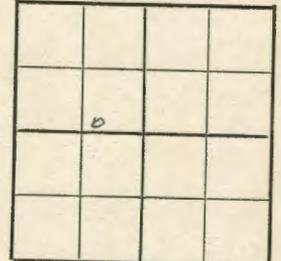

Miscellaneous

Location \_\_\_\_\_

Rig up \_\_\_\_\_

Drilling and Remarks:  
Miss 3170

RECORD

Cased \_\_\_\_\_ in., \_\_\_\_\_ ft.

Sand \_\_\_\_\_

Gas \_\_\_\_\_

Oil \_\_\_\_\_

Total Depth 8175

PRODUCTION

1st 24 hrs. Nat. \_\_\_\_\_

1st 24 hrs. after shot \_\_\_\_\_

Gas \_\_\_\_\_ Cu. Ft.

Dry Hole \_\_\_\_\_

Abandoned \_\_\_\_\_

Date

MAR 15 1944 19

S. J. LEWIS Scout