
Cowley KANSAS

SECTION 29 TOWNSHIP 34 RANGE 5E

WELL NO. #1 Boggs

COMPANY Winnona Oil Co.

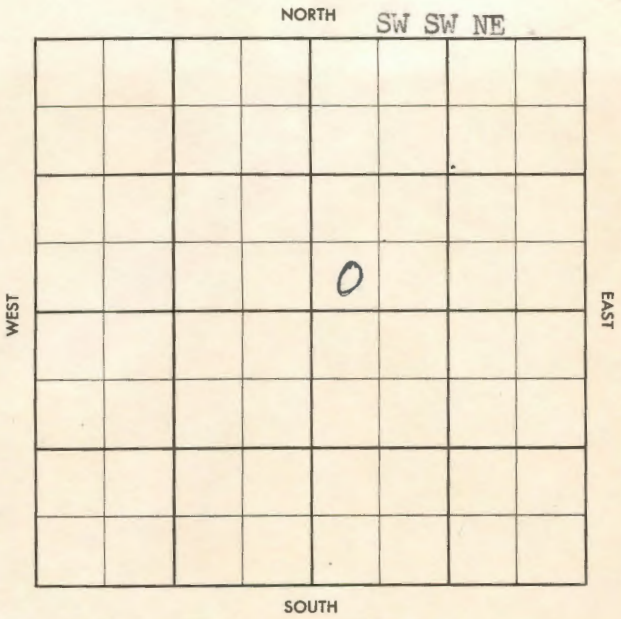

FORM 504-3 SUNRAY

FORM 513 SUNRAY

County Cowley Elev.
Sec. 29 Twp. 34 Rge. 5E
Company Winnona Oil Co.
Farm Name Boggs No. 1

TOPS	DEPTH	LOG	DATUM
Anh.			
Tp.			
H.			
Tr.			
Dg.			
Bl.			
L.			
K.C.			
B.K.C.			
Ce.			
C.			
M.			
M.			
K.			
Mz.			
Mo.			
V.			
S.			
S.			
A			
R.			
P€.			
G.			
T.D.			

Loc. in Sec. SW SW NE

Geol.
Contr. McKnab & Lindsay Tools Pool
Quarry

FIRST REPORT
MAR 13 '57

Date Comm.
Location

29

Co. Sec. T. R. No. Lse.

FORM 513 SUNRAY

County Cowley Elev. 1181
Sec. 29 Twp. 34 Rge. 5E
Company Winnona Oil Co.
Farm Name Boggs No. 1

TOPS	DEPTH	LOG	DATUM
Anh.			
Tp. Hogshtr		2280	
H. Lay 3d		2375	
Tr. Base Lay		2500	
Dg.			
Bl.			
L.		2535	
K.C.			
B.K.C.		2689	
Ce. clev sd			
C.			
M.			
M.			
K.			
Mz.			
Mo.			
V.			
S.			
S.			
A			
R.			
P€.			
G.			
T.D. 2725	~~2725~~		

Loc. in Sec. SW SW NE

Geol.
Contr. McKnab & Lindsay Tools Pool
Quarry

ABANDONED
APR 3 '57

Date Comm.
Location MAR 20 '57 RUR
3-20-57 8 5/8 @ 100 cmt
Layton APR 3 '57 DST 2692-2725
op 2 hrs rec 150' SCM
SIBHP 570/30

D & A

Co. Sec. T. R. No. Lse.