
Cowley KANSAS

SECTION 30 TOWNSHIP 34 RANGE 5E

WELL NO. #1 Lyon

COMPANY Yarnell Bros.

NORTH NW NW SW

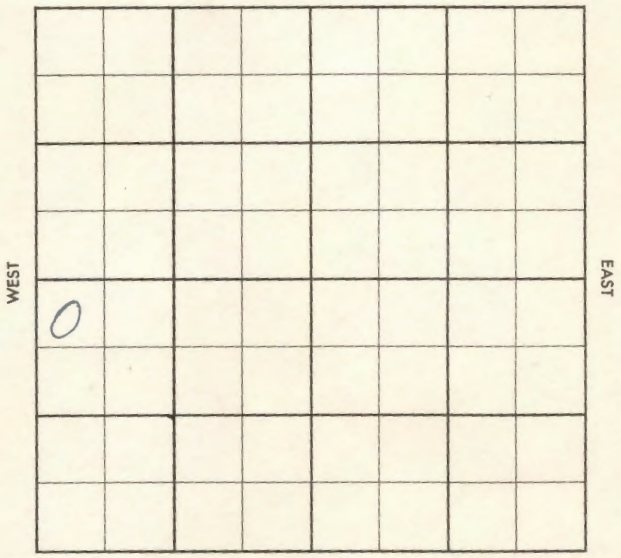

FORM 504-3 SUNRAY

FORM 513 SUNRAY

County Cowley Elev. 1193

Sec. 30 Twp. 34 Rge. 5E

Company Yarnell Bros.

Farm Name Lyon No. 1

TOPS	DEPTH	LOG	DATUM
Anh. Layt	X	2412	
Tp. Ec		2654	
H. Cleve.	2742	2758	
Tr. Osw.	2824	2836	
Dg.			
Bl. ~~Cattle~~	3044	3057	Cattle.
L. ~~Barty~~		~~3157~~	
K.C. Barth.		3161	
B.K.C.			
Ce.			
C.		3217	
M.		L.T.	
M.			
K			
Mz.			
Mo.			
V.			
S.			
S.			
A			
R.			
P€.			
G.			
T.D.	3281		

Loc. in Sec. NW NW SW

Geol.

Contr. Co. Tools

Pool Wildcat

ABANDONED

MAY 29 57

Date Comm. Texas Co. - (DHM)

Location MAY 15 57 5-10-57 Ft. 1

100' 70 M 1570 MAY 22 57 M 3145

MAY 29 57 X Log Tops DST 3235-42

Ihr rec 42' Md FBHP 70/30" DST

3243-53 op. Ihr. rec 42 Md.

FBHP 1150/30" RTD 328. Log

DCa

Kig Stack

Co. Lse. No. Sec. T. R.

FORM 513 SUNRAY

WILDCAT

County Cowley Elev.

Sec. 30 Twp. 34 Rge. 5E

Company Yarnell Bros.

Farm Name Lyon No. 1

TOPS	DEPTH	LOG	DATUM
Anh.			
Tp.			
H.			
Tr.			
Dg.			
Bl.			
L.			
K.C.			
B.K.C.			
Ce.			
C.			
M.			
M.			
K.			
Mz.			
Mo.			
V.			
S.			
S.			
A			
R.			
P€.			
G.			
T.D.			

Loc. in Sec. NW NW SW

Geol.

Contr. Co. Tools

Pool Wildcat

FIRST REPORT

MAY 8 57

Date Comm. Texas Co. - (DHM)

Location

29

Co. Lse. No. Sec. T. R.