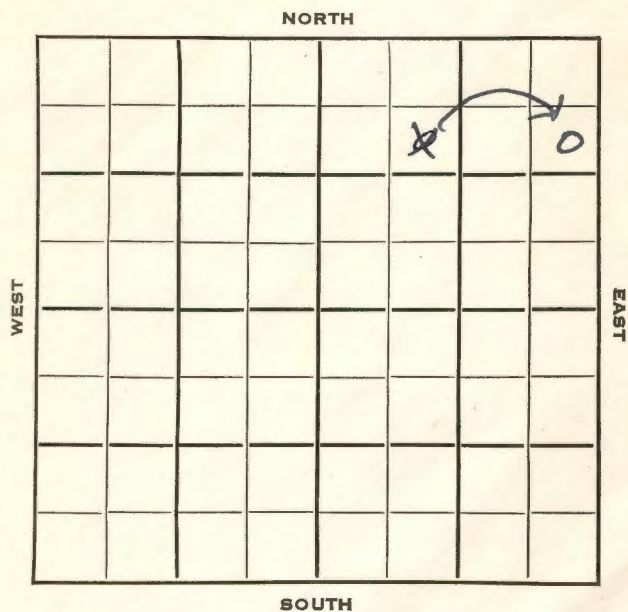


Section 34 Township 34 Range 5EWell No. #1 MetzCompany Salina Drlg. CompanySec. 34 Twp. 34 R. 5EWell No. #1 Metz Farm

Salina Drlg. Company

Contractor


1240
990 Ft. from N. Line

Ft. from S. Line

330 Ft. from E. Line

990 Ft. from W. Line

~~SE NW NE~~
SE NENE

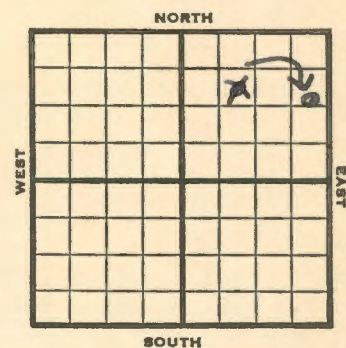

1953

Elev. 1236

REPORT

3/4

Spudding Date 2/28/53

8" @ 75

Drlg. 550

3/25

2-28-53

D & A

TD 3653

8" @ 75

Miss 3098,

DST 3098-3114 open 1 hr. Rec 20' ocm

Arb 3415

TD 3653

D & A

ABANDONED

J. G. McGEHEE

J. G. McGEHEE

Map No. _____ Sec. 34 Twp. 34 R. 5EWell No. 1 Mats

Salina Drlg. _____ Company

CORRECTION _____ Contractor

SE NE NE

SECTION PLAT

1240 Ft. from N. Line

_____ Ft. from S. Line

330 Ft. from E. Line

_____ Ft. from W. Line

Cowley County

Location _____

Rig up _____

Drilling and Remarks:

Reported

SE NW NE

RECORD

Cased _____ in., _____ ft.

Sand _____

Gas _____

Oil _____

Total Depth _____

PRODUCTION

1st 24 hrs. Nat. _____

1st 24 hrs. after shot _____

Gas _____ Cu. Ft.

Dry Hole _____

Abandoned _____

Date

MAR 11 1921

J. G. McGEHEE

Scout