



Section 23 Township 34 Range 5E
 Well No. #3 1 Devore
 Company Continental

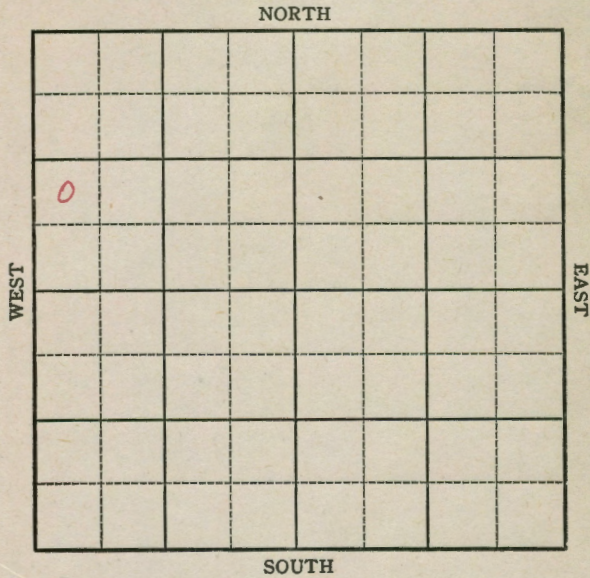

Sec. 23 Twp. 34 S R. 5 E
 Well No. #1 Devore Farm
 CONTINENTAL Company
 Miscellaneous

_____ Ft. from N. Line
1215 Ft. from S. Line
 _____ Ft. from E. Line
330 Ft. from W. Line

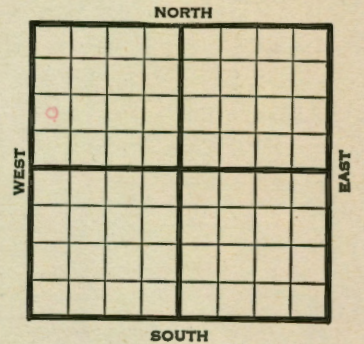

NW SW NW Elev. 1124

REPORT	
1945	Location
4-18	"
4/27	"
5/3	"
5/10	RUR
5/17	Surface Hole
5/24	10" @ 189
	Drlg. 2285
5/31	Bart. 2966
	6" @ 2967
	TD 2976' RUST
6/8	TD 2986 20 qts 2976-86 Flow
	20 oil in 1 1/2 hrs.
6/14	" " " "
7/3	Bart. 2966
	6" @ 2967
	TD 2986'
	20 qts. 2976-2986
	Pump 210 Pot.
	Grav. 38.0

COMPLETED

Kansas Pool Name Miscellaneous

Map No. 2 Sec. 23 Twp. 34 R. 5E

Well No. 3 Devore

Continental Company

CORRECTION Contractor

NW SW NW

SECTION PLAT

Ft. from N. Line

1215 Ft. from S. Line

Ft. from E. Line

330 Ft. from W. Line

o			

Cowley County

Location _____

Rig up _____

Drilling and Remarks:

**reported as
#1 Devore**

RECORD

Cased _____ in., _____ ft.

Sand _____

Gas _____

Oil _____

Total Depth _____

PRODUCTION

1st 24 hrs. Nat. _____

1st 24 hrs. after shot _____

Gas _____ Cu. Ft.

Dry Hole _____

Abandoned _____

Date

MAY 2 1945

S. J. LEWIS Scout

Kansas Pool Name Miscellaneous

Map No. 2 Sec. 23 Twp. 34 R. 5E

Well No. 1 Devore

Continental Company

FIRST REPORT Contractor

NW SW NW

SECTION PLAT

Ft. from N. Line

1215 Ft. from S. Line

Ft. from E. Line

330 Ft. from W. Line

o			

Cowley

Location X

Rig up _____

Drilling and Remarks:

RECORD

Cased _____ in., _____ ft.

Sand _____

Gas _____

Oil _____

Total Depth _____

PRODUCTION

1st 24 hrs. Nat. _____

1st 24 hrs. after shot _____

Gas _____ Cu. Ft.

Dry Hole _____

Abandoned _____

Date

APR 18 1945

S. J. LEWIS Scout

KANSAS

Pool Name Miscellaneous

Map No. 2 Sec. 23 Twp. 34 R. 5E

Well No. 3 Devore

Continental Company

COMPLETED

Contractor

NW, SW NW

E 11124

SECTION PLAT

 Ft. from N. Line

1215 Ft. from S. Line

 Ft. from E. Line

330 Ft. from W. Line

6			

Cowley County

Location

Rig up

Drilling and Remarks:

Bar 2966
6" @ 2967
20 ft. 2976-86
Pump 210 P.D.
198 0/4

RECORD

Cased in., ft.

Sand

Gas

Oil

Total Depth 2986

PRODUCTION

1st 24 hrs. Nat.

1st 24 hrs. after shot

Gas Cu. Ft.

Dry Hole

Abandoned

Date

JUL 3 1945 19

S. J. LEWIS Scout