


Cowley

Section 23 Township 34 Range 5-E
Well No. #1 Peck
Company Steinbuschel & Berger

NORTH Wildcat

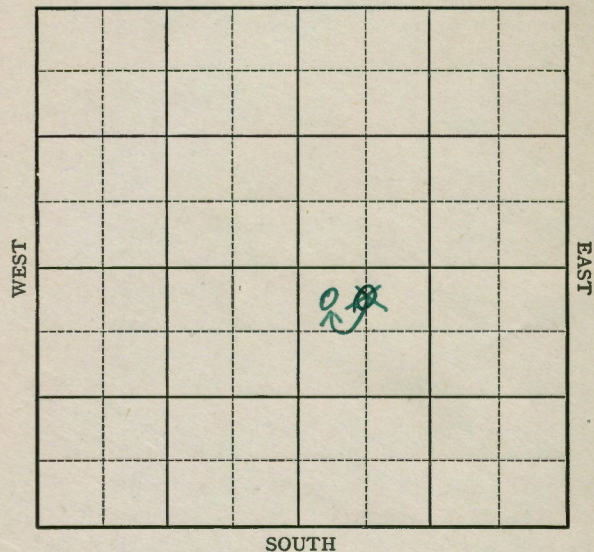


Cowley

Sec. 23 Twp. 34 R. 5-E
Well No. #1 Peck Farm _____
Steinbuschel & Berger Company _____
(Wildcat) NORTH

330 Ft. from N. Line
_____ Ft. from S. Line
~~660~~ Ft. from E. Line
330 Ft. from W. Line

Elev. 1092

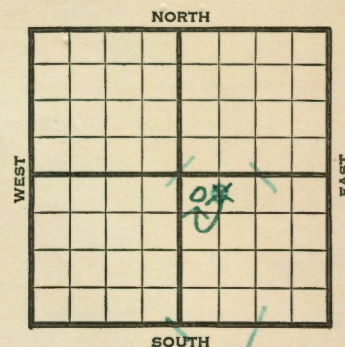

1941	REPORT
5/27	Material .
6/5	Machine.
6/12	Spud & SD.
6/19	Drlg. 450'
6/26	15" - 40' Drlg. 960'
7/3	SD 1200'
7/10	"
7/17	10" - 1200' Drlg. 1300'
7/24	1300 HR 10"
7/31	SD.
8/7	10" @ 1297'-1300 TD SD
8/15	Dlg. 1710'
8/21	8" - 1765' Drlg. 2010'
8/28	Drlg. 2235'
9/4	6" - 2410' C. O.
9/11	6" - 2410' Drlg. 2670'
9/18	Drlg. 3005'
	OVER

1941

9/24

Miss. 2973'

T.D. 3010'

No shows.

ABANDONED

Cowley

KANSAS

Map No. K-2 Sec. 23 Twp. 34 R. 5EWell No. 1 PeckSteinbuschel & Berger CompanyABANDONED

Contractor

NW SE

SECTION PLAT

330 Ft. from N. Line

Ft. from S. Line

Ft. from E. Line

330 Ft. from W. Line

WILDCAT

Location

Rig up

Drilling and Remarks:

*Miss 2973**Noelson's*

RECORD

Cased in. ft.

Sand

Gas

Oil

Total Depth 300

PRODUCTION

1st 24 hrs. Nat.

1st 24 hrs. after shot

Gas Cu. Ft.

Dry Hole

Abandoned

Date

SEP 24 1941 19S. J. LEWIS Scout

Cowley

KANSAS

Map No. 2 Sec. 23 Twp. 34 R. 5EWell No. 1 PeckSteinbuschel & Berger CompanyCORRECTION

Contractor

NW SE

SECTION PLAT

330 Ft. from N. Line

Ft. from S. Line

Ft. from E. Line

330 Ft. from W. Line

WILDCAT

Location

Rig up

Drilling and Remarks:

Reported

C N L NW SE

RECORD

Cased in. ft.

Sand

Gas

Oil

Total Depth

PRODUCTION

1st 24 hrs. Nat.

1st 24 hrs. after shot

Gas Cu. Ft.

Dry Hole

Abandoned

Date


AUG 20 1941 19S. J. LEWIS Scout

Map No. 2 Sec. 23 Twp. 34 R. 5EWell No. 1 PeckSteinbuschel & Berger Company

Contractor

FIRST REPORT**SECTION PLAT**

C N L NW SE

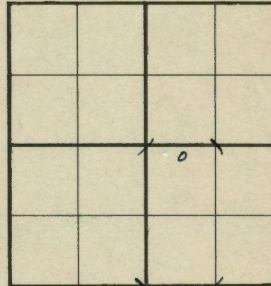330 Ft. from N. Line Ft. from S. Line660 Ft. from E. Line Ft. from W. Line**WILDCAT**Location Rig up

Drilling and Remarks:

Material**RECORD**Cased in., ft.Sand Gas Oil Total Depth **PRODUCTION**1st 24 hrs. Nat. 1st 24 hrs. after shot Gas Cu. Ft.Dry Hole Abandoned

Date

MAY 27 1941 19S. J. LEWIS Scout