

FORM 51 25M 3-49 PETROL

O.W.W.O.

Cowley


KANSAS

Section 28 Township 34 Range 5E

Well No. #1 Dunn

Company ORVILLE PARKER
Aylward

NORTH

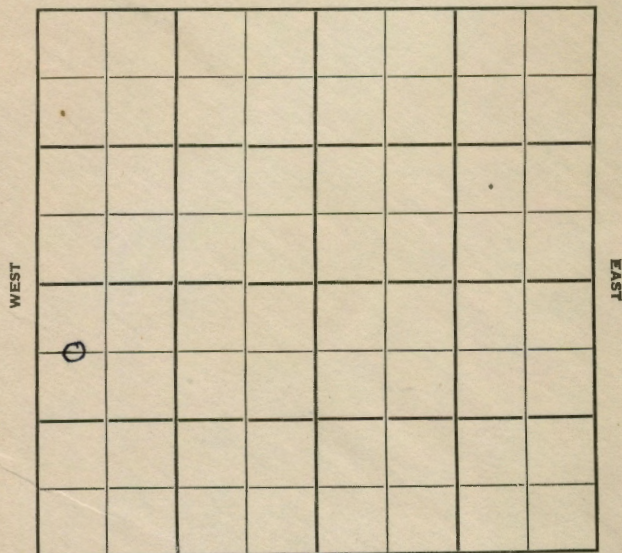

SOUTH

FORM 252-B
10M 8-51 TPCO.

Cowley

O.W.W.O.

KANSAS

Sec. 28 Twp. 34 R. 5E ✓

Well No. #1 Dunn Farm

ORVILLE PARKER
Aylward Company

Contractor

660

Ft. from N. Line

Ft. from S. Line


Ft. from E. Line

330

Ft. from W. Line

C W/2 NW SW

NORTH

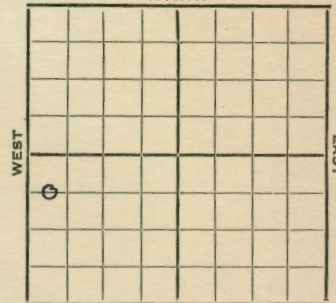

SOUTH

1952 Elev. 1192'

REPORT

5/28

MIR

6/4

Spud 6-1-52

D&A TD 3157

Layton 2412

KC 2591

DST 2682-2700 open $\frac{1}{2}$ hr. gas in 14 min. Gauge 150 mcf 35' vso & gcm

Bart. 3084 Miss. 3148-57

DST 3141-57 open 40 min. rec. 25' mud D&A

ABANDONED

1954

6/30

Layton 2412', KC 2591', Miss 3148',

OTD 3157'

To Test Cleveland Sand

9/22

Oil Well - TD 3157'

Layton 2412', KC 2591', Miss 3148'

OTD 3157'

Cleve 2682'

72/2684-2702,

5" @ 2800'

rac. F/6 boph


P/25 bopd VSSW

Comp. 21 bopd

COMPLETED

O.W.W.O.

County **Cowley** State **Kansas**
 Sec. **28** (Blk. Twp.) **34** (Sur. Rge.) **5E** Map No.
 Operator **Aylward**
 Well No. **1** Farm **Dunn**
 Elev. **1192** Location **C W 1/2 NW SW**

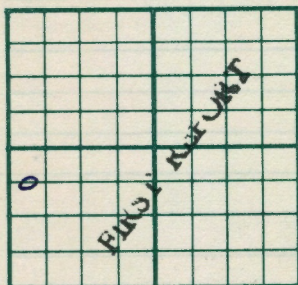


660 Ft. From **N** Line **SW**
330 Ft. From **W** Line Quarter
 1st. Report **MAY 28 1952**
 Completion
 Remarks
 Spudding Date

Drlg. Data

MIR**J. G. McGENEE**

County **Cowley** State **Kansas**
 Sec. **28** (Blk. Twp.) **34** (Sur. Rge.) **5E** Map No.
 Operator **Aylward Drlg.**
 Well No. **1** Farm **Dunn**
 Elev. **1192** Location **C W L NW SW**

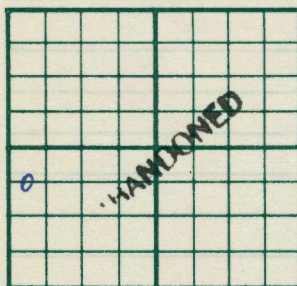

660 Ft. From **N** Line **SW**
330 Ft. From **W** Line Quarter
 1st. Report
 Completion **JUN 4 1952**
 Remarks
 Spudding Date **6-1-52**

Drlg. Data **D & A TD 3157**

Layton 2412 KC 2591 DST 2682-2700
 open $\frac{1}{2}$ hr. gas in 14 min. gauge 150 mcf
 35' vso & gcm Bart. 3084 Miss. 3148-57
 DST 3141-57 open 40 min. Rec. 25' mud
D & A

J. G. McGENEE

O.W.W.O.

County **Cowley** State **Kansas**

Sec. **28** (Blk. **34** (Sur. **5E** Map No.

Operator **Orville Parker**

Well No. **1** Farm **Dunn**

Elev. Location **C W $\frac{1}{2}$ NW SW**

						660	Ft. From	N	Line	SW
						330	Ft. From	W	Line	Quarter

1st. Report **JUN 30 1954**

Completion

Remarks **OWWO**
O.W.W.O.

Spudding Date

Drig. Data

Layton 2412 KC 2591 Miss. 3148
OTD 3157 to test Cleveland sand

J. G. McGEHEE

O.W.W.O.

County **Cowley** State **Kansas**

Sec. **28** (Blk. **34** (Sur. **5E** Map No.

Operator **Orville Parker**

Well No. **1** Farm **Dunn**

Elev. Location **C W $\frac{1}{2}$ NW SW**

						660	Ft. From	N	Line	SW
						330	Ft. From	W	Line	Quarter

1st. Report **Jun 30 1954**

Completion **SEP 22 1954**

Remarks **OWWO**
O.W.W.O.

Spudding Date

Drig. Data Oil well TD 3157

Layton 2412 KC 2591 Miss. 3148
OTD 3157 Cleve. 2682 72/ 2684-2702
5" @ 2800 frac F/ 6 boph P/ 25 bopd
VSSW Comp. 21 bopd

FABEN GILSTRAP