


Section 29 Township 34 Range 5E

Well No. 1 Hockinberry

Company Orville Parker

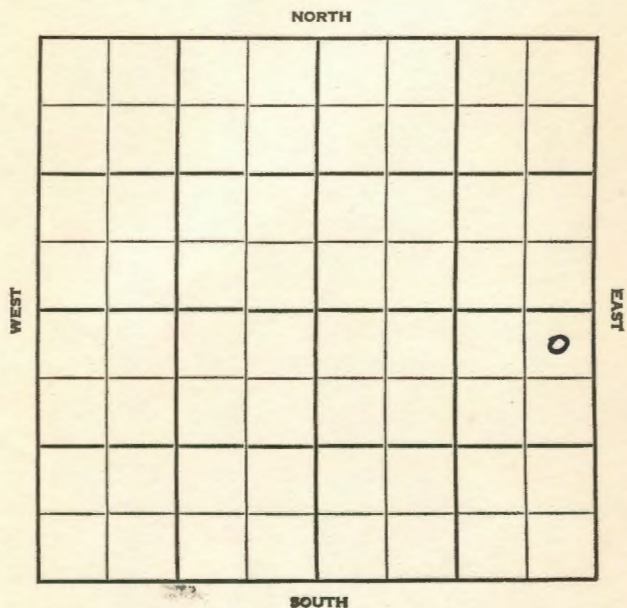

SEC. TWP. R.

29 34 5 E

WELL NO. # 1 Hockinberry FARM

COMPANY

CONTRACTOR Orville Parker

Smitherman


330 Ft. from N. Line

Ft. from S. Line

330 Ft. from E. Line

Ft. from W. Line

NE NE SE

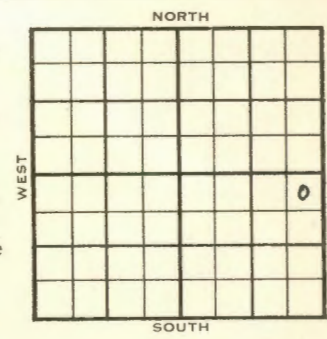

	ELEVATION	REPORT
1954	1147'	
8/4	Spud 7-31-54 8" @ 90 Drlg. 2020'	
9/22	Spud 7-31-54 - Oil Well TD 2700' 8" @ 90' Stal. 1865', Hayton 2318', Cleve 2644' TD 2700' 5" @ 2700' 42/2645-52 Sd-frac P/40 bopd Comp. 31 bopd	

1954

ELEVATION 1147'

REPORT

8/4

Spud 7-31-54  
8" @ 90  
Drlg. 2020'

9/22

Spud 7-31-54 - Oil Well  
TD 2700'  
8" @ 90'  
Stal. 1865', Hayton 2318', Cleve 2644'  
TD 2700'  
5" @ 2700'  
42/2645-52  
Sd-frac  
P/40 bopd  
Comp. 31 bopd

COMPLETED

County **Cowley** State **Kansas**  
 Sec. **29** (Blk. **34** (Sur. **5E** Map No. **5E**)  
 Operator **Orville Parker**  
 Well No. **1** Farm **Hockinberry**  
 Elev. **1147** Location **NE NE SE**


**330** Ft. From **N** Line **SE**  
**330** Ft. From **E** Line **Quarter**  
 Ist. Report **Aug 4 1954**  
 Completion **SEP 22 1954**  
 Remarks  
**Smitherman - Contr.**  
 Spudding Date **7-31-54**

Drig. Data **Oil well TD 2700**  
**8" @ 90 Stal. 1865 Layton 2318**  
**Cleve. 2644 TD 2700 5" @ 2700**  
**42/ 2645-52 sd-frac P/ 40 bopd**  
**Comp. 31 bopd**

**FABEN GILSTRAP**

County **Cowley** State **Kansas**  
 Sec. **29** (Blk. **34** (Sur. **5E** Map No. **5E**)  
 Operator **Orville Parker**  
 Well No. **1** Farm **Hockinberry**  
 Elev. Location **NE NE SE**


**330** Ft. From **N** Line **SE**  
**330** Ft. From **E** Line **Quarter**  
 Ist. Report **AUG 4 1954**  
 Completion  
 Remarks  
**Smitherman - Contr.**  
 Spudding Date **7-31-54**

Drig. Data  
**8" @ 90 drlg. 2020**

**J. G. McGEHEE**