


Section 5 Township 34 Range 2E

Well No. 1 Canfield

Company Salina Drlg.

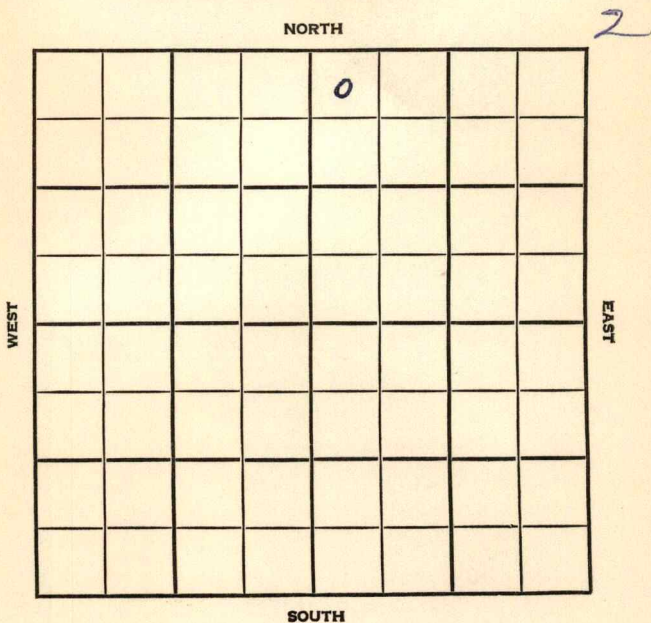

Sumner

KANSAS

SEC. TWP. R.

WELL NO. 5 34 2 E

COMPANY # 1 Canfield FARM

CONTRACTOR Salina Drlg.


Wildcat

330 Ft. from N. Line

Ft. from S. Line

Ft. from E. Line

330 Ft. from W. Line

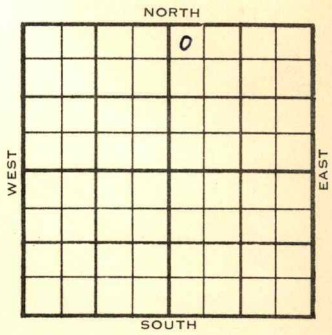

NW NW NE

Sunray - DHM

ELEVATION

REPORT

1954

1173'

8/25

Spud 8-18-54
8" @ 116 Stal. 2388
Drlg. 2444'

12/8

Spud 8-18-54 D & A TD 3843
8" @ 116 Stal. 2388 Layton 2812
KC 2992 Miss 3448
DST 3450-55 open 1 hr rec 8' SO &
GCM 65#
DST 3449-62 open 1 hr rec 30' HO &
GCM 170# TD 3636 Simp. 3754
Arb. 3823 TD 3843 5" @ 3838
CO to 3799 24/3764-70 S/wtr.
24/3756-60 S/32 GWPH PB 3500
25/3452-58 100 MA FU 40' wtr.
12/3459-65 8/3466-70 16/3469-73
12/3474-80 15 GWPH 500 MA 6 GO
690 GW 12 hr. D & A

ABANDONED

County **Sumner** State **Kansas**

Sec. **5** (Blk.) **34** (Sur.) **2E** Map No.

Operator **Salina Drlg.**

Well No. **1** Farm **Canfield**

Elev. Location **NW NW NE**

330 Ft. From **N** Line **NE**
330 Ft. From **W** Line Quarter

1st. Report **AUG 25 1954**

Completion

Remarks **Sunray - DHM**

Spudding Date **8-18-54**

Drlg. Data **Wildcat**
8" @ .116 Stal. 2388 drlg. 2444

FABEN GILSTRAP

