


Map No. 12 Sec. 34 Twp. 6 R. E
 Well No. 1-Brubaker Farm
Trus Oil Co Company

NORTH

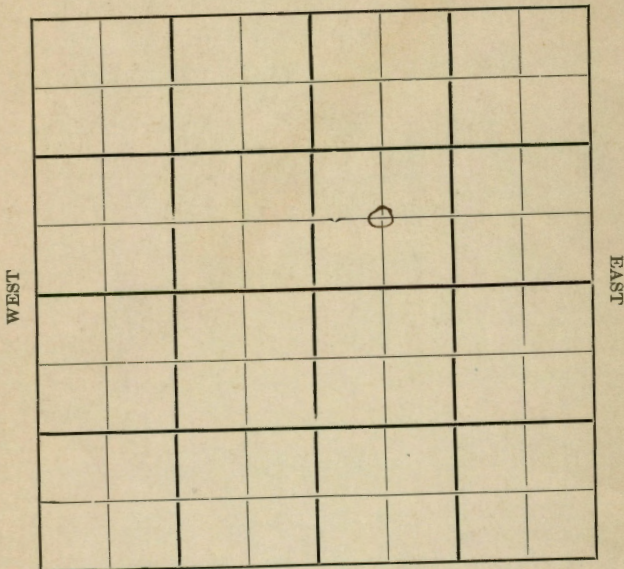

WEST

EAST

SOUTH

Location
 Drilling Remarks

Rig Up
 Drilling Remarks

RECORD


PRODUCTION

Cased in. ft.
 Sand
 Gas
 Oil
 Total Depth

1st 24 hrs. Nat.
 1st 24 hrs. after shot
 Gas cu. ft.
 Dry Hole
 Abandoned

Map No. 12 Sec. 34 Twp. 6 R. E
 Well No. 1-Brubaker Farm
Trus Oil Co Company

NORTH

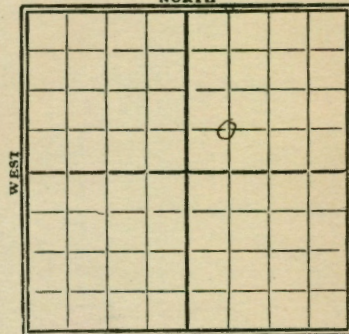

WEST

EAST

SOUTH

Ft. from N. Line

660 Ft. from S. Line

Ft. from E. Line

660 Ft. from W. Line

1929

Date

REPORT

7/2 RoS.
7/10
7/17
7/24
7/31 machine
8/17 only 382'
8/14 set 6"-1000'
8/21 sand 1068-97
7/14 TD 1097
Helium gas
Comp.

Cowley
 2 **KANSAS** Sec. *12* Twp. *34* R. *6^E*
 Map No. *1* *Brubaker*
 Well No. *Jess Oil Co.* Company

Contractor

FIRST REPORTS

Ft. from N. Line

660 Ft. from S. Line

Ft. from E. Line

660 Ft. from W. Line

SECTION PLAT

Location

Rig up

Drilling and Remarks:

RECORD

Cased in., ft.

Sand

Gas

Oil

Total Depth

PRODUCTION

1st 24 hrs. Nat.

1st 24 hrs. after shot

Gas Cu. Ft.

Dry Hole

Abandoned

Date

CHAS. L. SHERWOOD

Scout

Cowley
 2 **KANSAS** Sec. *12* Twp. *34* R. *6*
 Map No. *1* *Brubaker*
 Well No. *Jess Oil Co.* Company

Contractor

COMPLETE

SECTION PLAT

Ft. from N. Line

660 Ft. from S. Line

Ft. from E. Line

660 Ft. from W. Line

Location

Rig up

Drilling and Remarks:

Helium gas.

RECORD

Cased in., ft.

Sand

Gas

Oil

Total Depth

PRODUCTION

1st 24 hrs. Nat.

1st 24 hrs. after shot

Gas *7 M* Cu. Ft.

Dry Hole

Abandoned

Date

CHAS. L. SHERWOOD

Scout