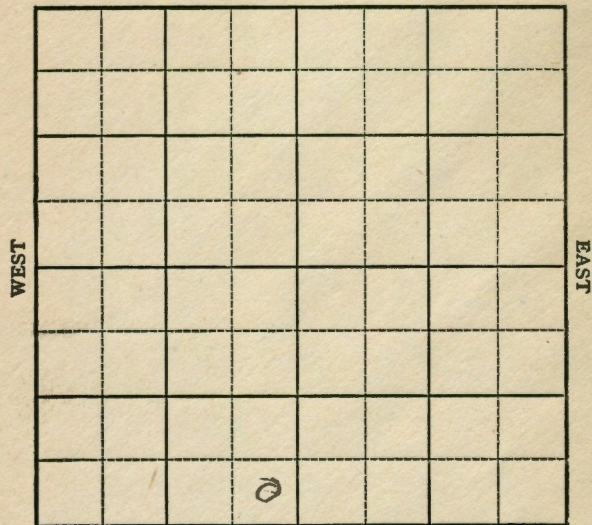


KANSAS Cowley

Section 13 Township 34 Range 6EWell No. 1 LortonCompany Frank PhelpsMisc.
NORTH

SOUTH

KANSAS Cowley ✓

Sec. 13 Twp. 34 R. 6EWell No. 1 Lorton FarmFrank Phelps Company


Misc.

_____ Ft. from N. Line

330 Ft. from S. Line330 Ft. from E. Line

_____ Ft. from W. Line

SE SW

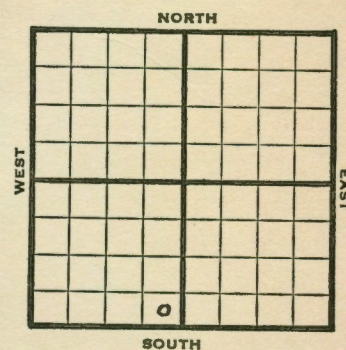

1948 Elev. 1401' REPORT

9/22 Drilling 2020'

9/29 12" @ 840'

8" @ 1710'

Drlg. 2120'

10/6 Layton 2120'
TD 214210/13 Layton 2120'
8" @ 1710'

Pump 48 oil & 40 W Pot.

Gr. 38°


TD 2142'

COMPLETED

Map No. 2 Sec. 13 Twp. 34 R. 6EWell No. 1 LortonFrank Phelps CompanyCOMPLETE Contractor

SE SW

SECTION PLAT

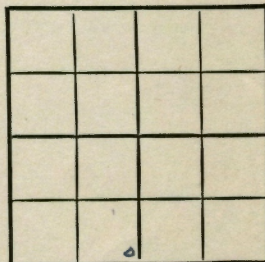

Ft. from N. Line

330 Ft. from S. Line330 Ft. from E. Line

Ft. from W. Line

Cowley County

Location

Rig up

Drilling and Remarks:

Lorton 2/2021710Pump. 45 ft. + 40WPT88-4

RECORD

Cased in ft.

Sand

Gas

Oil

Total Depth 2172

PRODUCTION

1st 24 hrs. Nat.

1st 24 hrs. after shot

Gas Cu. Ft.

Dry Hole

Abandoned

Date

OCT 13 1948 19S. J. LEWIS


Scout

Cowley County Kansas StateMap No. Sec. 13 Twp. 34 R. 6EWell No. 1 LortonFrank Phelps CompanyFIRST REPORT

Contractor

SE SW

SECTION PLAT

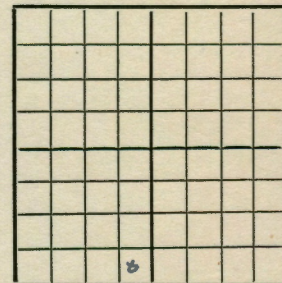

Ft. from N. Line

330 Ft. from S. Line330 Ft. from E. Line

Ft. from W. Line

Miscellaneous

Remarks:

drlg. 2020Date
SEP 22 1948Scout
S. J. LEWIS