


Map No. KANSAS Sec. 12 Twp. 34 R. 6 <sup>E</sup>

Well No. 1-M.J. Brubaker Farm

Shes, Oil Co Company

NORTH

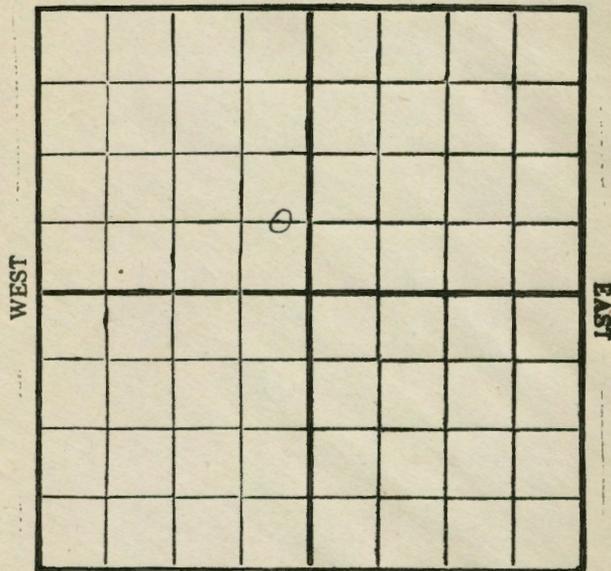

SOUTH

Location \_\_\_\_\_

Drilling Remarks \_\_\_\_\_

Rig Up \_\_\_\_\_

Drilling Remarks \_\_\_\_\_

\_\_\_\_\_  
\_\_\_\_\_  
RECORD

Cased \_\_\_\_\_ in. \_\_\_\_\_ ft.  
Sand \_\_\_\_\_  
Gas \_\_\_\_\_  
Oil \_\_\_\_\_  
Total Depth \_\_\_\_\_

PRODUCTION


1st 24 hrs. Nat. \_\_\_\_\_  
1st 24 hrs. after shot \_\_\_\_\_  
Gas \_\_\_\_\_ cu. ft. \_\_\_\_\_  
Dry Hole \_\_\_\_\_  
Abandoned \_\_\_\_\_

Map No. KANSAS Sec. 12 Twp. 34 R. 6 <sup>E</sup>

Well No. 1-M.J. Brubaker Farm

Shes, Oil Co Company

NORTH

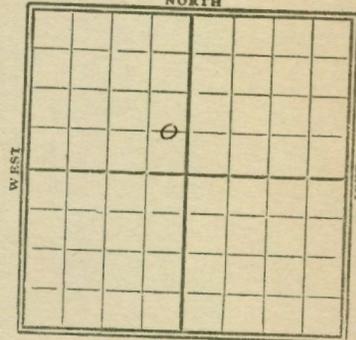

SOUTH

\_\_\_\_\_ Ft. from N. Line

660 Ft. from S. Line

220 Ft. from E. Line

\_\_\_\_\_ Ft. from W. Line

1929

Date

REPORT

9/18 Machine  
9/25 \_\_\_\_\_  
10/2 \_\_\_\_\_  
10/19 \_\_\_\_\_  
10/16 \_\_\_\_\_  
10/23 Spdy.  
10/30 Drbg 450'  
11/6 sand 1135-61'  
           show gas & HFW  
           5D. 1161'  
11/13 J.D. 1161'  
           Dry & Abandon

Map No. **KANSAS** Sec. *17* Twp. *34* R. *6 E*  
Well No. *1* *M. J. Brubaker*  
*Trues Oil Co* Company

**FIRST REPORTS**

**SECTION PLAT**

..... Ft. from N. Line  
*660* Ft. from S. Line  
*270* Ft. from E. Line  
..... Ft. from W. Line

		o	

Location.....  
Rig up *Machin*  
Drilling and Remarks:

**RECORD**

Cased..... in., ..... ft.  
Sand.....  
Gas.....  
Oil.....  
Total Depth.....

**PRODUCTION**

1st 24 hrs. Nat.....  
1st 24 hrs. after shot.....  
Gas..... Cu. Ft.  
Dry Hole.....  
Abandoned.....

Date  
**SEP 18 1929**

**CHAS. L. SHERWOOD**

..... 192..... Scout

*Cowley*  
Map No. **KANSAS** Sec. *17* Twp. *34* R. *6*  
Well No. *1* *M. J. Brubaker*  
*Trues Oil Co* Company

**COMPLETE**

**SECTION PLAT**

..... Ft. from N. Line  
*660* Ft. from S. Line  
*270* Ft. from E. Line  
..... Ft. from W. Line

		o	

**ABANDONED**

Location.....  
Rig up.....  
Drilling and Remarks:

**RECORD**

Cased..... in., ..... ft.  
Sand.....  
Gas.....  
Oil.....  
Total Depth *1161*

**PRODUCTION**

1st 24 hrs. Nat.....  
1st 24 hrs. after shot.....  
Gas..... Cu. Ft.  
Dry Hole   
Abandoned

Date  
**NOV 13 1929**

**CHAS. L. SHERWOOD**

..... 192..... Scout