

KANSAS

Cowley

Section 12 Township 34 Range 6-E

Well No. #1 Foltz

Company Greeley Drlg.

Cowley **KANSAS**

Sec. 12 Twp. 34 R. 6E

Well No. #1 Foltz Farm _____

Greeley Drlg. Company _____

Otto Pool Contractor _____


Ft. from N. Line _____

990' Ft. from S. Line _____


330' Ft. from E. Line _____

Ft. from W. Line _____

NE SE NW

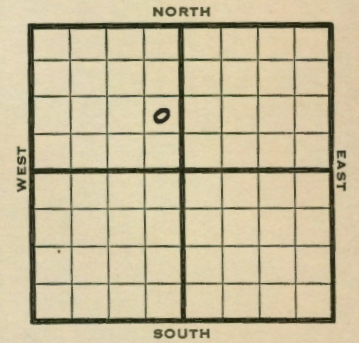

NORTH

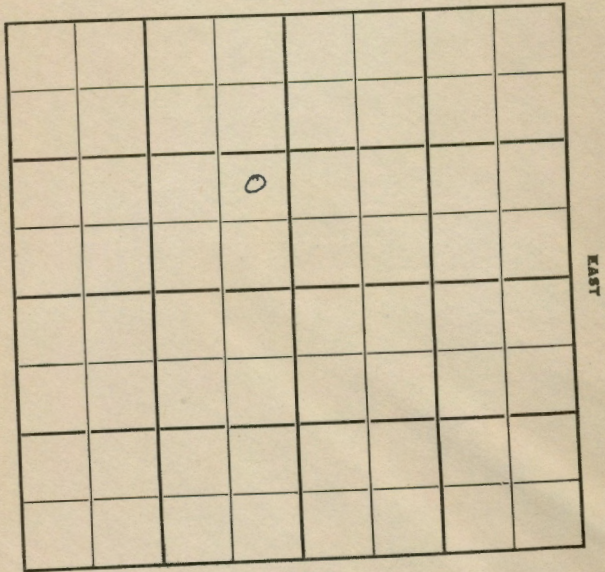

SOUTH

1950

REPORT

Elev 1362

8/16 8-5/8" @ 63'

Drlg. 1475'

Spud 8-9-50

8/30 8 5/8" @ 63

Miss 2935 Arb 3340

TD 3360

D&A

ABANDONED

