


SECTION 17 TOWNSHIP 34 RANGE 6E

WELL NO. #1 Waldschmidt "B"

COMPANY Crest Petroleum

NORTH NW SW NW

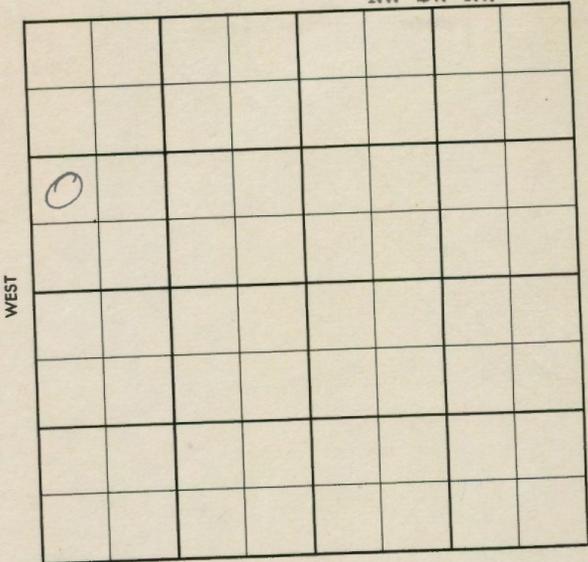

SOUTH

WEST

EAST

WILDCAT

FORM 513 SUNRAY

County ~~Cowley~~ Elev. _____

Sec. 17 Twp. 34 Rgs. 6E

Company Crest Petroleum

FarmName Waldschmidt "B" No. 1

TOPS	DEPTH	LOG	DATUM	Loc. in Sec.
Anh.				NW SW NW
TP.				
H.				
Tr.				
Dg.				
Bl.				
L.				Geol. _____
K.C.				Contr. _____
B.K.C.				Wrico Tools
Ce.				
C.				Pool _____
M.				Wildcat
Mz.				
Me.				
V.				
S.				
S.				
A.				
R.				
PE.				
G.				
TD.				

FIRST REPORT

MAY 29 1957

Date Comm.

M I R T

30

~~Handwritten signature~~

County Cowley Elev. 1212 Co.
 Sec. 17 Twp. 34 Rge. 6E
 Company Crest Petroleum
 FarmName Waldschmidt "B" No. 1

TOPS	DEPTH	LOG	DATUM	Loc. in Sec.
Anh.				NW SW NW
Tr.	<u>stain</u>	<u>1758</u>		
L.	<u>Lat zn</u>	<u>2193</u>		
K.C.	<u>" sd</u>	<u>2214</u>		Geol.
B.K.C.	<u>KC</u>	<u>2444</u>		Contr.
Ce.	<u>osw</u>	<u>2622</u>		<u>Wrico Tools</u>
C.e.	<u>zn</u>	<u>2766</u>		<u>waldschmidt</u>
M.	<u>chat</u>	<u>3020</u>		Pool <u>South</u>
M.	<u>LI</u>	<u>3045</u>		<u>Wildert</u>
K.				
Mr.				
Me.				
V.				
S.				
S.				
A.				
R.				
PE.				
G.				
T.B.	<u>3083</u>			COMPLETE

Date Comm. MIRT JUN 5 57 5-31-57 858
101/80 M 2436 JUN 12 '57
5 1/2" 3083/150 MICT 44/
3025-33 notst M FU
12 B0 + 3 B Acid Wtr. JUN 19 '57
DST 2211-21 1hr run
450' M3W FP 18-217 BHP
769/20" Frac 1/2 x 3 Flw 9
ld. JUN 26 '57 \$ 10 BOPH + 4BW
TBR POP JUL 3 '57 JUL 10 '57 JUL 17 '57

P 9 BOPH + 4 BW pd JUN 24 57
JUL 31 '57 Ph P. 35 BOPH + 58% wtr
grau 41.6%

17-34-6E

NW SW NW