


Cowley

KANSAS

SECTION 17 TOWNSHIP 34 RANGE 6E

WELL NO. #1 Walschmidt "D"

COMPANY Crest Petroleum Co.

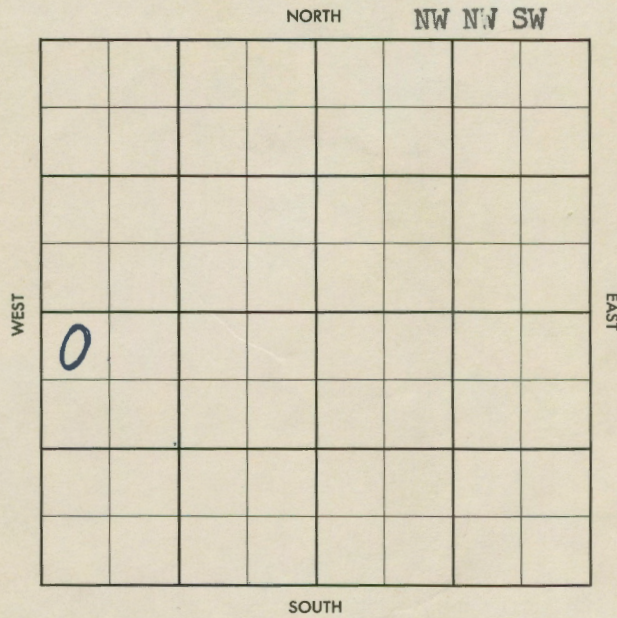

County Cowley Elev. 1286
 Sec. 17 Twp. 34 Rgs. 6E
 Company Crest Petroleum Co.
 FarmName Walschmidt "D" No. 1

TOPS	DEPTH	LOG	DATUM	Loc. in Sec.
Anb.				NW NW SW
TP.				
H. <u>stain</u>	<u>1812</u>			
Tr. <u>lay</u>	<u>2263</u>			
Dg. <u>" 3d</u>	<u>2380</u>			
Bl.				
L.				Geol.
K.C.	<u>2516</u>			Contr.
B.K.C.	<u>05W</u>	<u>2699</u>		<u>Wrico Drlg.</u>
Ce.	<u>2867</u>			Pool
C.				Unnamed
M. <u>chert</u>	<u>3100</u>			
M. <u>LI</u>	<u>3125</u>			
K.				
Mz.				
Mo.				
V.				
S.				
S.				
A.				
R.				
PE.				
G.				
T.D.	<u>3150</u>			

COMPLETE
 SEP 4 57

Date Comm. 6-20-57
8" @ 100/80, Drlg. 2030 JUL 3 57 5 1/2
3149/100 JUL 10 57 36/3104-10
1/4 @ 100 Bopd + lots wt
Doc 50 Frac @ 8 Bopd +
Tr. wt Pop JUL 24 57 11 1/2 57 wopot
AUG 8 57 ✓ wopot. AUG 14 57 ✓ wopot.
AUG 21 57 AUG 28 57 X Pot. 29 SEP 4 57
Ph P. 28 Bopd 80% wt
gran 39°

County Cowley Elev. _____
 Sec. 17 Twp. 34 Rgs. 6E
 Company Crest Petroleum Co.
 FarmName Walschmidt "D" No. 1

TOPS	DEPTH	LOG	DATUM	Loc. in Sec.
Anb.				NW NW SW
TP.				
H.				
Tr.				
Dg.				
Bl.				
L.				Geol.
K.C.				Contr.
B.K.C.				<u>Wrico Drlg.</u>
Ce.				Pool
C.				Unnamed
M.				
M.				
K.				
Mz.				
Mo.				
V.				
S.				
S.				
A.				
R.				
PE.				
G.				
T.D.				

FIRST REPORT
 JUN 26 57

Date Comm. 6-20-57
8" @ 100/80, Drlg. 2030
30