


Map No. Kansas Sec. 24 Twp. 34 R. 6

Well No. 1 Day Farm

S. H. E. Pet Co Company

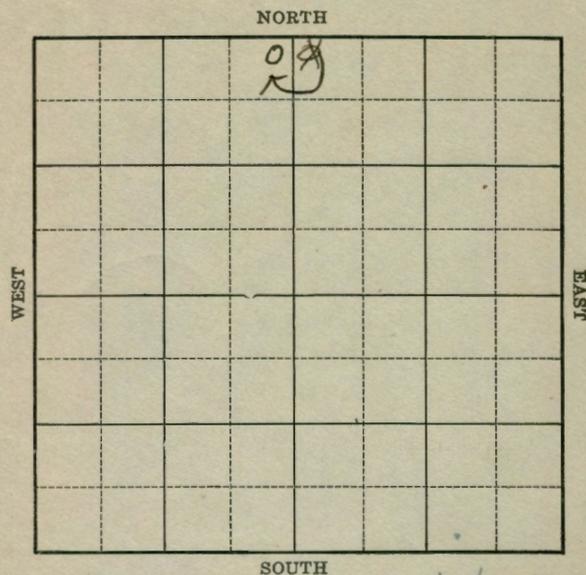

1400

Location _____ Rig Up _____


Drilling Remarks _____ Drilling Remarks _____

RECORD		PRODUCTION	
Cased _____ in.	_____ ft.	1st 24 hrs. Nat.	_____
Sand _____		1st 24 hrs. after shot	_____
Gas _____		Gas _____	cu. ft.
Oil _____		Dry Hole	_____
Total Depth _____		Abandoned	_____

Map No. Kansas Sec. 24 Twp. 34 R. 6

Well No. 1 Day Farm

S. H. E. Pet Company

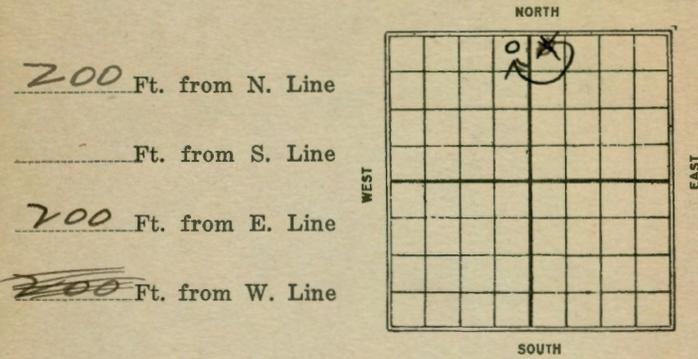

200 Ft. from N. Line
 _____ Ft. from S. Line
200 Ft. from E. Line
~~200~~ Ft. from W. Line

Date	REPORT
<u>1/25</u>	
<u>11/13</u>	Location
<u>11-19</u>	Blqy Ry
<u>11/27</u>	Spudg.
<u>12/3</u>	Drly 265'
<u>12/10</u>	✓ 800
<u>12/17</u>	S. D. 1175'
<u>12/23</u>	_____
<u>12/31</u>	Drly 1275'
<u>1926</u>	
<u>1/8</u>	Fishing 1400'
<u>1/14</u>	Drly 1900'
<u>1/20</u>	✓ 2050'
<u>1/27</u>	I.S. 2133-2180' 2M gas shot 80 gts, Est 30 bbls.
<u>2/4</u>	I.S. (connected) 2125-2136' 2M gas. Sand 2143-2182' shot 90 gts, 15 bbls. oil. 7 barrels water.
<u>2/10</u>	Pumping 15 bbls oil. 25 bbls water. not completed
<u>2/17</u>	- Will drill deeper.
<u>2/24</u>	Running 6" 2260
<u>3/5</u>	W.R. 24 50.

3/10 - W.R. 6" 2990 2590
 3/18 - 10 bbl show 2684-90
 Top of lime 2950 Alg -
 2980.

3/25 - Alg 2330
 4/1 " 3340

4/7 - J.D. 3369' Will plug
 back to Buille Sand
 and shoot.

4/14 - _____
 4/21 - _____

4/28 - P.B. to 2168' shot 110 gts
 small showing oil
 cleaning out.

5/5 - Sand 2141-2168.
 J.D. 3369 top line.
 2950. P.B. Buille Sand.
 2141-68 90 gts 20 oil
 20 water

2950
 1400
 1550

Form 26-1M Bks.-3-23-11959.

Cowley Co
 Map No. *K2* KANSAS Sec. *74* Twp. *34* R. *6*
 Well No. *1* *Dry*
S.H.E. pet Co Company

Contractor

FIRST REPORTS

SECTION PLAT

200 Ft. from N. Line
 _____ Ft. from S. Line
 _____ Ft. from E. Line
200 Ft. from W. Line

		0	

Location _____
 Rig up _____
 Drilling and Remarks: _____

RECORD

Cased _____ in., _____ ft.
 Sand _____
 Gas _____
 Oil _____
 Total Depth _____

PRODUCTION

1st 24 hrs. Nat. _____
 1st 24 hrs. after shot _____
 Gas _____ Cu. Ft.
 Dry Hole _____
 Abandoned _____

Date
 NOV 13 1925

CHAS. L. SHERWOOD
 Scout

Map No. **K2 KANSAS** Sec. **24** Twp. **34** R. **6**

Well No. **1** Day **Let Co** Company

Contractor

COMPLETED

SECTION PLAT

200 Ft. from N. Line
Ft. from S. Line
200 Ft. from E. Line
Ft. from W. Line

Location

Rig up
Drilling and Remarks:
Top limo 2950'
T.D. 3369'
Plugged back to
Bill sd 2141-68
90' 20' ss old
20' 20' ss shaly

RECORD

Cased _____ in., _____ ft.
Sand **2141-2168**
Gas _____
Oil _____
Total Depth **3369**

PRODUCTION

1st 24 hrs. Nat. _____
1st 24 hrs. after shot _____
Gas _____ Cu. Ft.
Dry Hole _____
Abandoned _____

Date **MAY 5 1926**

CHAS. L. SHERWOOD
Scout

Map No. **K2 KANSAS** Sec. **24** Twp. **34** R. **6**

Well No. **1** Day **Let Co** Company

Contractor

CORRECTION

SECTION PLAT

200 Ft. from N. Line
Ft. from S. Line
200 Ft. from E. Line
Ft. from W. Line

Location

Rig up
Drilling and Remarks:
Log Rig

RECORD

Cased _____ in., _____ ft.
Sand _____
Gas _____
Oil _____
Total Depth _____

PRODUCTION

1st 24 hrs. Nat. _____
1st 24 hrs. after shot _____
Gas _____ Cu. Ft.
Dry Hole _____
Abandoned _____

Date **NOV 19 1925**

CHAS. L. SHERWOOD
Scout