


Cowley KANSAS

Section 18 Township 34 Range 6-E

Well Number 1 Walld-Schmidt

(Waldschmidt)

Company McKnabb

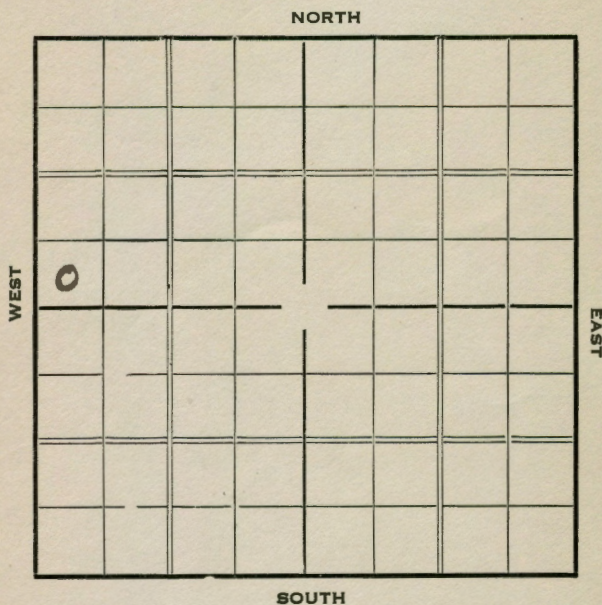

KANSAS Cowley

Map No. Sec. 18 Twp. 34 R. 6-E

Well No. #1 Walldschmidt


McKnabb Company

Ft. from N. Line

330 Ft. from S. Line

Ft. from E. Line

330 Ft. from W. Line

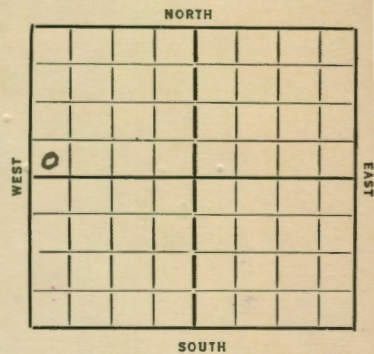

Date 1936 REPORT

- 12/16 R O G
- 12/24 Rigging up
- 12/29 " "
- 1937
- 1/7 Shut down 150'.
- 1/14 Drlg. 225'.
- 1/21 15" @ 348'. Drlg. 650'.
- 1/28 Drlg. 1250'.
- 2/4 Drlg. 1310'.
- 2/11 Drlg. 1630'.
- 2/18 Drlg. 1900'.
- 2/26 8" @ 2071. Drlg. 2115'
- 3/4 Drlg. 2440'.
- 3/11 2478' under rean 8"
- 3/18 6" @ 2938' Drlg. 2952'
- 3/25 Chat 3032'. Drlg. 3275'.
- 4/2 Drlg. 3503'.

OVER

1937

4/7

Wilcox 3510'.

T. D. 3520'.

Hold full water.

**ABANDONED**

**KANSAS** Cowley

Map No. 2 Sec. 18 Twp. 34 R. 6E

Well No. 12 Va Holschmidt

McKna & Co. Company

Contractor

**SECTION PLAT**


Ft. from N. Line

330 Ft. from S. Line

Ft. from E. Line

330 Ft. from W. Line

**ABANDONED**

Location \_\_\_\_\_

Rig up \_\_\_\_\_

Drilling and Remarks:

W. 20 x 25 10  
NAW

**RECORD**

Cased \_\_\_\_\_ in., \_\_\_\_\_ ft.

Sand \_\_\_\_\_

Gas \_\_\_\_\_

Oil \_\_\_\_\_

Total Depth 3520

**PRODUCTION**

1st 24 hrs. Nat. \_\_\_\_\_

1st 24 hrs. after shot \_\_\_\_\_

Gas \_\_\_\_\_ Cu. Ft.

Dry Hole

Abandoned

Date

APR 7 1937 19

S. J. LEWIS Scout

Map No. 2 Sec. 18 Twp. 34 R. 6E

Well No. 12 Va Holschmidt

McKna & Co. Company

Contractor

**SECTION PLAT**


Ft. from N. Line

330 Ft. from S. Line

Ft. from E. Line

330 Ft. from W. Line

**FIRST REPORT**

Location \_\_\_\_\_

Rig up \_\_\_\_\_

Drilling and Remarks:

ROG

**RECORD**

Cased \_\_\_\_\_ in., \_\_\_\_\_ ft.

Sand \_\_\_\_\_

Gas \_\_\_\_\_

Oil \_\_\_\_\_

Total Depth \_\_\_\_\_

**PRODUCTION**

1st 24 hrs. Nat. \_\_\_\_\_

1st 24 hrs. after shot \_\_\_\_\_

Gas \_\_\_\_\_ Cu. Ft.

Dry Hole \_\_\_\_\_

Abandoned \_\_\_\_\_

Date

DEC 16 1936 19

S. J. LEWIS Scout