



Section 24 Township 34 Range 6E
 Well No. #1 Barnett
 Company Ayesh Oil

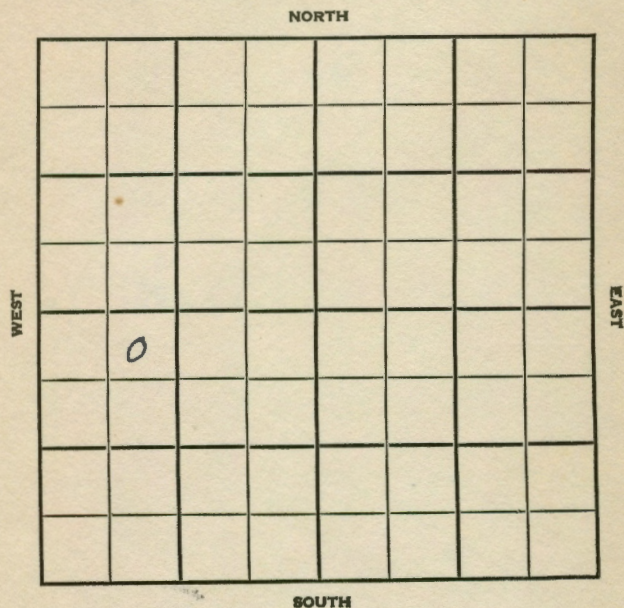

SEC. 24 TWP. 34 R. 6E
 WELL NO. #1 Barnett FARM
 COMPANY Ayesh Oil
 CONTRACTOR Bedell & Catt

Otto Pool

330 _____ Ft. from N. Line
 _____ Ft. from S. Line
 _____ Ft. from E. Line
 990 _____ Ft. from W. Line

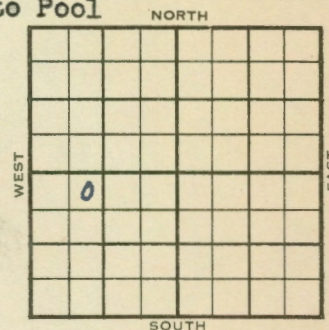

NE NW SW

1955

ELEVATION

1376'

REPORT

4/13

Spud 4-8-55
 8" @ 100'
 Drlg. 600'

4/27

Spud 4-8-55 D & A TD 2996'
 8" @ 100 Stal. 1631 Layton 2118
 DST 2120-48 open 1 hr rec 900' SW
 625# Oswego 2545' Cherokee 2719'
 Miss. 2955
 DST 2948-58 open 1/2 hr, rec 10' mud
 90# TD 2996' D & A

ABANDONED

County	Cowley	State	Kansas
Sec.	24	(Blk. Twp.) 34 (Sur. Rge.) 6E	Map No.
Operator	Ayesh Oil		
Well No.	1	Farm	Barnett
Elev.	1376	Location	NE NW SW

330 Ft. From N Line SW
990 Ft. From W Line Quarter

1st. Report

Completion **APR 27 1955**

Remarks	Otto Pool
	Bedell & Catt - Contr.

Spudding Date 4-8-55

Drig. Data D & A TD 2996

8" @ 100 Stal. 1631 Layton 2118
DST 2120-48 open 1 hr. Rec. 900' sw

625#	Oswego	2545	Cherokee	2719
------	--------	------	----------	------

Miss. 2955 DST 2948-58 open $\frac{1}{2}$ hr.

Rec. 10' mud 90# TD 2996

D & A

FABEN GILSTRAP

County	Cowley		State	Kansas
Sec.	24	(Blk. Twp.)	34	(Sur. Rge.) 6E Map No.
Operator	Ayesh Oil			
Well No.	1	Farm	Barnett	
Elev.	Location		NE NW SW	

0

FIRST REPORT

330 Ft. From N Line SW
990 Ft. From W Line Quarter

1st. Report APR 13 1955

Completion

Remarks
Bedell & Catt - Contr.

Spudding Date 4-8-55

Drlg. Data Otto Pool

8" @ 100 drlg. 600

FABEN GILSTRAP