


Cowley KANSAS

Section 24 Township 34 Range 6 E

Well No. # 2 Sauer

Company V. A. James

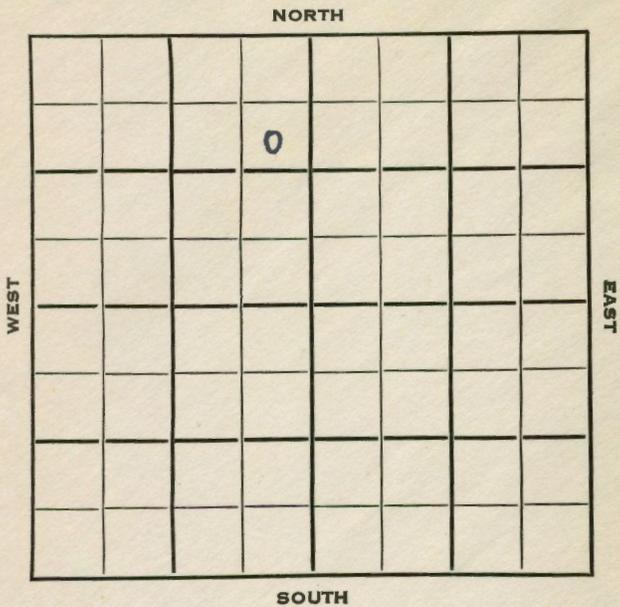

SEC. 24 TWP. 34 R. 6 E ✓

WELL NO. # 2 Sauer FARM

COMPANY V. A. James

CONTRACTOR Uhl.

990 Ft. from N. Line

Ft. from S. Line

330 Ft. from E. Line

Ft. from W. Line

SE NE NW

	ELEVATION	REPORT
1953	1399'	
10/21	RUR	
12/16	Spud 10-21-53 Oil Well TD 1642' 10" @ 88' Hoover 1449', TD 1453' 5" @ 1450' Stal. 1622' TD 1642' PB 1459' sd-oil-frac Comp 24 bopd 30 bw.	COMPLETED

