


Map No. KANSAS Sec. 28 Twp. 34 R. 6

Well No. 1- Lickup Farm

Lario O & S Company

NORTH

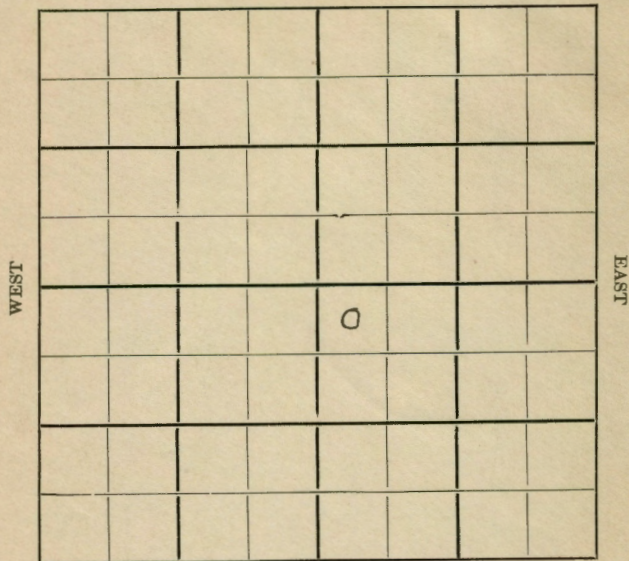

SOUTH

Location..... Rig Up.....
Drilling Remarks..... Drilling Remarks.....

RECORD

PRODUCTION


Cased..... in..... ft. 1st 24 hrs. Nat.....
Sand..... 1st 24 hrs. after shot.....
Gas..... cu. ft.....
Oil..... Dry Hole.....
Total Depth..... Abandoned.....

Map No. KANSAS Sec. 28 Twp. 34 R. 6

Well No. 1- Lickup Farm

Lario O & S Company

NORTH

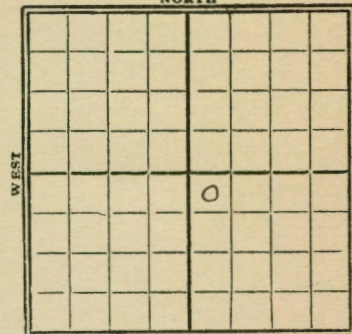

SOUTH

330 Ft. from N. Line

_____ Ft. from S. Line

_____ Ft. from E. Line

330 Ft. from W. Line

1929

Date

REPORT

Date	REPORT
2/27	Location
3/6	7/31
3/13	8/7
3/20	8/14
3/27	8/21
4/3	8/28
4/10	9/4
4/17	9/11
4/24	9/18
5/1	9/25
5/8	10/2 - Abandon
5/15	location
5/22	
5/29	
6/5	
6/12	
6/19	
6/26	
7/2	
7/10	
7/17	
7/24	

Map No. **2** **KANSAS** Sec. **28** Twp. **34** R. **6**

Well No. **P1** **Silkey**
Harro Oil & Gas Co. Company

Contractor

FIRST REPORTS

330 Ft. from N. Line

Ft. from S. Line

Ft. from E. Line

330 Ft. from W. Line

SECTION PLAT

		0	

Location ☒

Rig up

Drilling and Remarks:

RECORD

Cased.....in.,ft.

Sand.....

Gas.....

Oil.....

Total Depth.....

PRODUCTION

1st 24 hrs. Nat.....

1st 24 hrs. after shot.....

Gas.....Cu. Ft.

Dry Hole.....

Abandoned.....

Date

FEB 27 1929

192

CHAS. L. SHERWOOD

Scout

Map No. **2** **KANSAS** Sec. **28** Twp. **34** R. **6**

Well No. **P1** **Silkey**
Harro Oil & Gas Co. Company

Contractor

COMPLETE

330 Ft. from N. Line

Ft. from S. Line

Ft. from E. Line

330 Ft. from W. Line

SECTION PLAT

		0	

ABANDONED

Location

Rig up

Drilling and Remarks:

RECORD

Cased.....in.,ft.

Sand.....

Gas.....

Oil.....

Total Depth.....

PRODUCTION

1st 24 hrs. Nat.....

1st 24 hrs. after shot.....

Gas.....Cu. Ft.

Dry Hole.....

Abandoned **Location**

Date

OCT 2 1929

19

CHAS. L. SHERWOOD

Scout