


Cowley

KANSAS

SECTION 35 TOWNSHIP 34 RANGE 6E

WELL NO. #1 Lady

COMPANY McNeish & Grallap

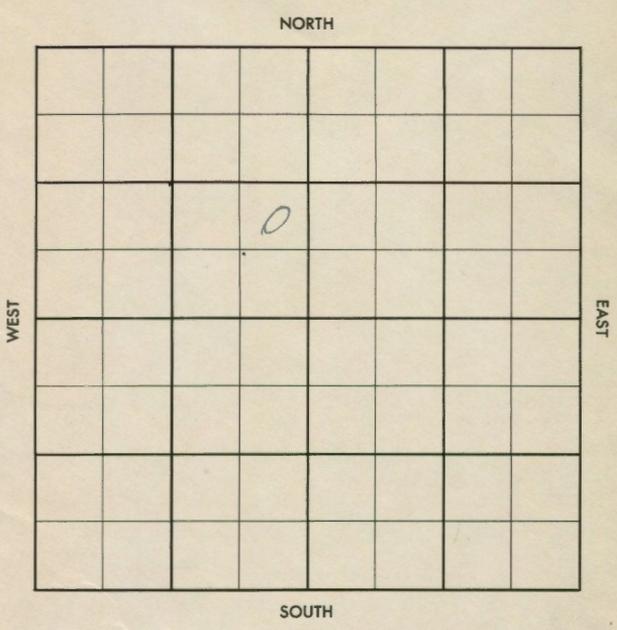

Cowley

KANSAS

SEC. 35 TWP. 34 R. 6E

WELL NO. #1 Lady

COMPANY McNeish & Grallap

CONTRACTOR Watson Drlg Tools


Wildcat

_____ FT. FROM N. LINE

_____ FT. FROM S. LINE

_____ FT. FROM E. LINE

_____ FT. FROM W. LINE

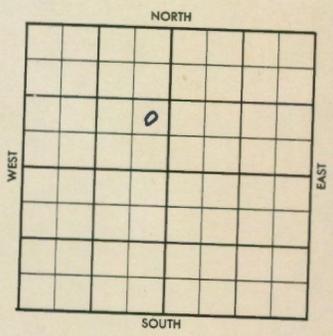

NE SE NW

1956	ELEVATION	REPORT
------	-----------	--------

9-12	MIRT
------	------

County Cowley Elev. _____
 Sec. 35 Twp. 34 Rge. 6E
 Company McNeish & Grallar
 Farm Name Lady No. 1

TOPS	DEPTH	LOG	DATUM	Loc. in Sec.
Anh.				
Tp. <u>Lay</u>		<u>2210</u>		<u>NE SE NW</u>
H.				
Tr.				
Dg.				
Bl.				
L.				
K.C.		<u>2430</u>		Geol. _____
B.H.C.		<u>2613</u>		Contr. _____
Ce.				<u>Watson Delp.</u>
G.				<u>Tools</u>
M.		<u>3006</u>		<u>Pool</u>
M.				<u>Wildcat</u>
K.				
Mz.				
Me.				
V.				
S.				
S.				
A.				
R.				
Pe.				
G.				
T.D.	<u>3032</u>			

Date Comm.

MIRT SEP 10 '56 9-10-56 858
105 D 2614 SEP 26 '56
DST 3006-32 1hr rec 20' M
BHP 40

D&A.

County Cowley Elev. _____
 Sec. 35 Twp. 34 Rge. 6E
 Company McNeish & Grallar
 Farm Name Lady No. 1

TOPS	DEPTH	LOG	DATUM	Loc. in Sec.
Anh.				
Tp.				<u>NE SE NW</u>
H.				
Tr.				
Dg.				
Bl.				
L.				
K.C.				Geol. _____
B.H.C.				Contr. _____
Ce.				<u>Watson Delp.</u>
C.				<u>Tools</u>
M.				<u>Pool</u>
M.				<u>Wildcat</u>
K.				
Mz.				
Me.				
V.				
S.				
S.				
A.				
R.				
Pe.				
G.				
T.D.				

Date Comm.

MIRT

3/6

Wildcat
SEP 12 '56