


Section 36 Township 34 Range 6-E

Well Number #1 Rush

Company Wentz & Amerada

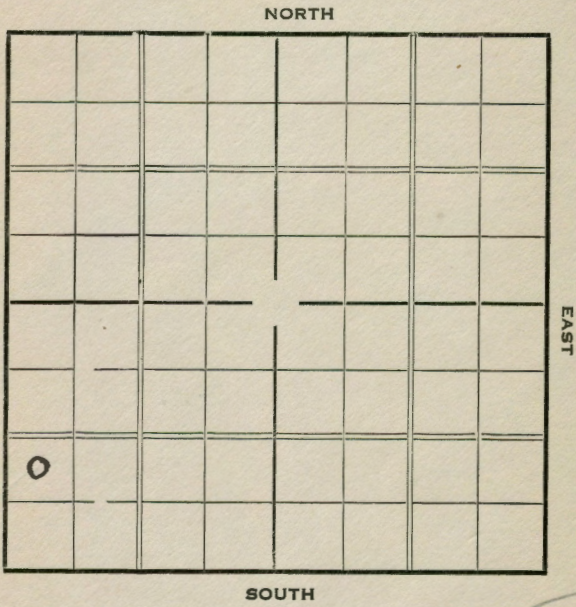

SOUTH

1365

Sec. 36 Twp. 34- R. 6-E

Well No. #1 Rush Farm


Wentz & Amerada Company

Ft. from N. Line

990 Ft. from S. Line

Ft. from E. Line

330 Ft. from W. Line

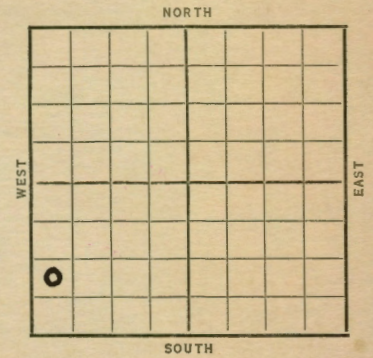

Date 1937 REPORT 1365 45

2/10 Cable rig.

2/18 Spud

2/26 Drlg. 250'

3/4 12" @ 1258' Drlg.

3/11 Drlg. 1530'

3/18 10" @ 1735' Drlg.

3/25 2059' underream 10".

4/2 Drlg. 2270'.

4/7 Bart. Sd. 2930-62'.

Chat 3015-25'.

T. D. 3046'.

Hole full water.

ABANDONED

2930	3015
1365	1365
1565	1650

Cowley

Map No. 2 Sec. 36 Twp. 34 R. 6E

Well No. 1 Rush

Wentz & Amerasia Company
Contractor

SECTION PLAT

_____ Ft. from N. Line

990 Ft. from S. Line

_____ Ft. from E. Line

380 Ft. from W. Line

ABANDONED

Location _____

Rig up _____

Drilling and Remarks:

Bar Sol 2930-62
Cha 3015-25
HPW

RECORD

Cased _____ in., _____ ft.

Sand _____

Gas _____

Oil _____

Total Depth 3046

PRODUCTION

1st 24 hrs. Nat. _____

1st 24 hrs. after shot _____

Gas _____ Cu. Ft.

Dry Hole

Abandoned

Date

APR 7 1937 19

S. J. LEWIS Scout

Cowley

Map No. 2 Sec. 36 Twp. 34 R. 6E

Well No. 1 Rush

Wentz & Amerasia Company
Contractor

SECTION PLAT

_____ Ft. from N. Line

990 Ft. from S. Line

_____ Ft. from E. Line

330 Ft. from W. Line

FIRST REPORT

Location _____

Rig up _____

Drilling and Remarks:

Case rig

RECORD

Cased _____ in., _____ ft.

Sand _____

Gas _____

Oil _____

Total Depth _____

PRODUCTION

1st 24 hrs. Nat. _____

1st 24 hrs. after shot _____

Gas _____ Cu. Ft.

Dry Hole _____

Abandoned _____

Date

FEB 10 1937 19

S. J. LEWIS Scout