


Cowley

KANSAS

SECTION 6 TOWNSHIP 34 RANGE 6 EWELL NO. #1 RoweCOMPANY Wrico Drlg. & E. A. Bradley

NORTH

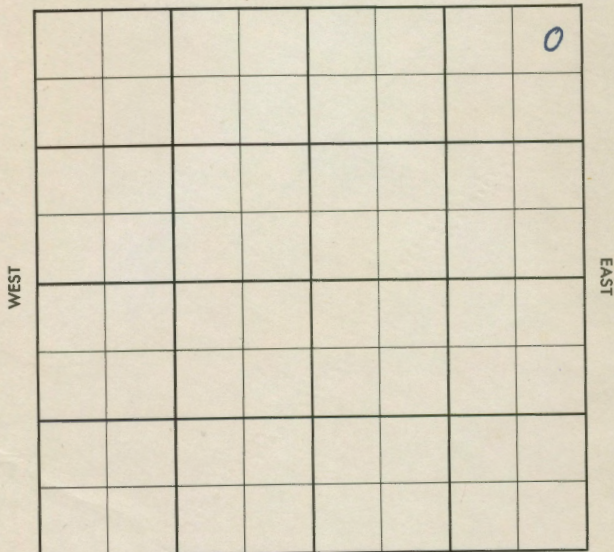

SOUTH

Cowley

KANSAS

SEC. 6- TWP. 34 R. 6E

WELL NO.

#1 Rowe

FARM

COMPANY

Wrico Drlg. & E.A. Bradley

CONTRACTOR

Co. tools

Cabin Valley

NORTH


Ft. from N. Line

Ft. from S. Line

Ft. from E. Line

Ft. from W. Line

NE NE NE

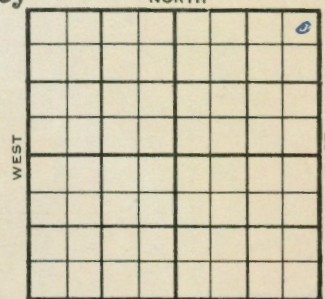

SOUTH

1955

ELEVATION

1128'

REPORT

12-7

Comm. 12-1-55

8" @ 76/65

#1 5" @ 2174/75

Layton zn. 2102

Layton Sd. 2128

Layton sdy sh. 2139

TD 2175'

12-28

CO, 24/ 2130-34, 1½ boph, 33% wtr.

P/ 100 bopd,

Comp. 25 bopd, 35% wtr.

COMPLETED

DX-78

County <u>Cowley</u>		Elev. <u>1128</u>		Co.
Sec. <u>6</u>	Twp. <u>34</u>	Rge. <u>6E</u>		
Company <u>Wrico Drlg. & E. A. Bradley</u>				
FarmName <u>Rowe</u>		No. <u>1</u>		

TOPS	DEPTH	LOG	DATUM	Loc. in Sec.
Anh.				NE NE NE
TP.				
H.				
Tr.				
Dg. <u>Layton</u>	<u>2102</u>		<u>974</u>	
Bl.				
L. <u>Layton sd.</u>	<u>2128</u>		<u>1000</u>	Geol.
K.C.				
B.K.C.				Contr.
Ce.				Co. tools
C. <u>Layton sdysh</u>	<u>2139</u>		<u>1011</u>	
M.				Pool
M.				Cabin Valley
K.				
Mz.				
Ma.				
V.				
S.				
S.				
A.				
R.				
PE.				
G.				
TD.	<u>2125</u>			

Date Comm. 12-1-55 DEC 28 1955

8" @ 76/65 5" @ 2174/75 CO

24/ 2130-34 1 1/2 boph 33% wtr.

P/ 100 bopd Comp. 25 bopd 35% wtr.

County <u>Cowley</u>		Elev. <u>6E</u>		Co.
Sec. <u>6</u>	Twp. <u>34</u>	Rge. <u>6E</u>		
Company <u>Wrico Drlg. & E. A. Bradley</u>				
FarmName <u>Rowe</u>		No. <u>1</u>		

TOPS	DEPTH	LOG	DATUM	Loc. in Sec.
Anh.				NE NE NE
TP.				
H.				
Tr.				
Dg. <u>Layton</u>	<u>2102</u>			
Bl.				
L. <u>Layton sd.</u>	<u>2128</u>			Geol.
K.C.				
B.K.C.				Contr.
Ce.				Co. tools
C. <u>Layton sdysh</u>	<u>2139</u>			
M.				Pool
M.				Cabin Valley
K.				
Mz.				
Ma.				
V.				
S.				
S.				
A.				
R.				
PE.				
G.				
TD.	<u>2175</u>			

Date Comm. 12-1-55

8" @ 76/65 5" @ 2174/75