


DX 78-1


COWLEY

KANSAS

Section 6 Township 34S Range 6E
 Well No. #4 Rowe
 Company Wrico & Bradley

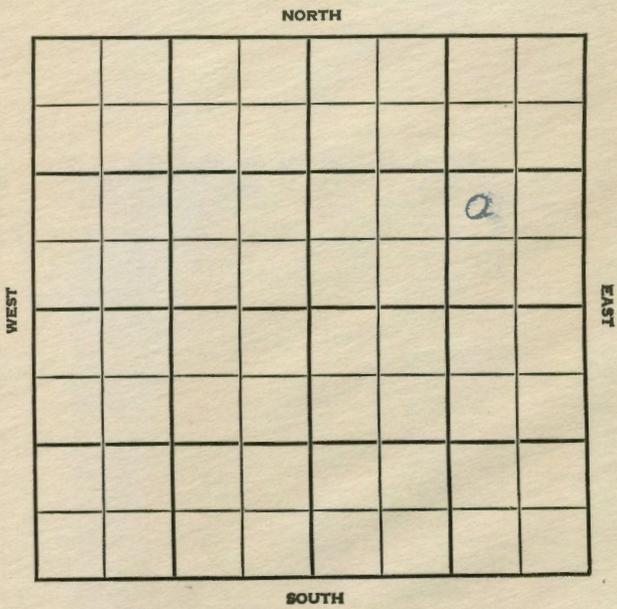

SEC. 6 TWP. 34S- R. 6E
 WELL NO. 4 Rowe FARM
 COMPANY Wrico & Bradley
 CONTRACTOR Wrico
Cabin Valley

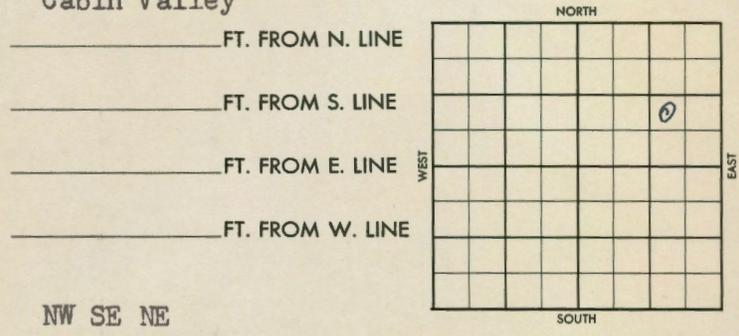

_____ FT. FROM N. LINE
 _____ FT. FROM S. LINE
 _____ FT. FROM E. LINE
 _____ FT. FROM W. LINE

NW SE NE

	ELEVATION	REPORT
1956	1136	
6-20	Comm. 6-15-56 8" @ 84 w/75 Stuck 2123'	
7-11	5 1/2" @ 2197 CO 30/2124-28 Frac; Flw 50 BO / 29 BW in 16 hrs., FLW 25 BO / 5 BWPD Lay 2126'; TD 2199'	

COMPLETED

County ~~Cowley~~ Elev. _____
 Sec. 6 Twp. 34S Rgs. 6E
 Company Wrico & Bradley
 FarmName Rowe No. 4

TOPS	DEPTH	LOG	DATUM	Loc. in Sec.
Anh.				NW SE NE
Tr.				
Dg.				
Bl.				
L.				Geol. _____
K.C.				Contr. _____
B.K.C.				
Ce.				Wrico
C.				Pool _____
M.				
M.				Cabin Valley
Mz.				
Mo.				
V.				
S.				
S.				
A				
R.				
Pe.				
G.				
T.D.				



Date Comm. 6/15/56 JUN 20 '58
8" 84 w/75, Stuck 2123

310

0001 2 5 1111

[Handwritten signature]

Co.
No.
Sec.
T.
R.