


KANSAS

Cowley

FORM 51 5M PETROL

Section 6 Township 34 Range 6E
 Well No. 1 Waldschmidt
 Company Continental

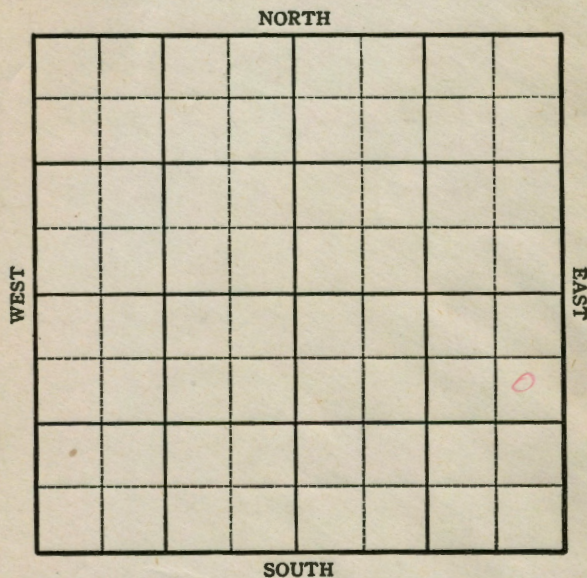

SOUTH

5M 8-45 PETROL

Cowley


Sec. 6 Twp. 34 R. 6-E
 Well No. #1 Waldschmidt Farm
Continental Company

990 Ft. from N. Line

 Ft. from S. Line

330 Ft. from E. Line

 Ft. from W. Line

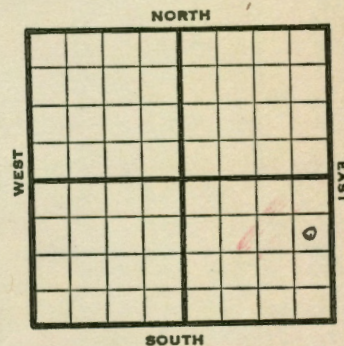

SE NE SE

SOUTH

1945

Elev. 1121

REPORT

10/10

Location

10/17

RUR

10/24

10" @ 164 WOC

10/31

Dr1g. 2340

11/7

Bart 2864

TD 2872

6" @ 2864 RUST

11/14

TD 2893

20 qts. 2878-2888 CO

11/21

" " " "

11/28

" " " "

12/5

" " " "

12/12

Bart 2864

6" @2864

TD 2893

Flow 132 Pot.

Grav. 39.0

COMPLETED

FORM 28 200 BAS. 1-44 PETROL
KANSAS Pool Name Miscellaneous

Map No. K-2 Sec. 6 Twp. 34 R. 6E

Well No. 1 Waldschmidt

Continental Company

COMPLETED

Contractor

SE NE SE


E 1/124
SECTION PLAT

990 Ft. from N. Line

Ft. from S. Line

330 Ft. from E. Line

Ft. from W. Line

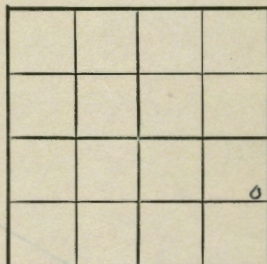

Cowley Cou ty

Location

Rig up

Drilling and Remarks:

Bar 2864

6" 02864

Flow 132 BX

89° 34'

RECORD

Cased in., ft.

Sand

Gas

Oil

Total Depth 2893

PRODUCTION

1st 24 hrs. Nat.

1st 24 hrs. after shot

Gas Cu. Ft.

Dry Hole

Abandoned

Date

DEC 12 1945 19

S. J. LEWIS

Scout

FORM 28 200 BAS. 1-44 PETROL
KANSAS Pool Name Miscellaneous

Map No. 2 Sec. 6 Twp. 34 R. 6E

Well No. 1 Waldschmidt

Continental Company

FIRST REPORT

Contractor

SE NE SE


SECTION PLAT

990 Ft. from N. Line

Ft. from S. Line

330 Ft. from E. Line

Ft. from W. Line

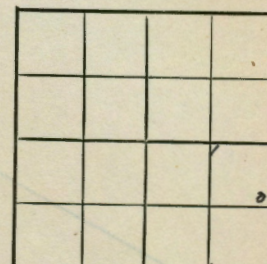

Cowley County

Location X

Rig up

Drilling and Remarks:

RECORD

Cased in., ft.

Sand

Gas

Oil

Total Depth

PRODUCTION

1st 24 hrs. Nat.

1st 24 hrs. after shot

Gas Cu. Ft.

Dry Hole

Abandoned

Date

OCT 10 1945 19

S. J. LEWIS

Scout