

KANSAS


FORM 51 5M PETROL

Cowley

Section 7 Township 34 Range 6E

Well No. #1 W. Kavanugh (Kavanaugh)

Company Continental

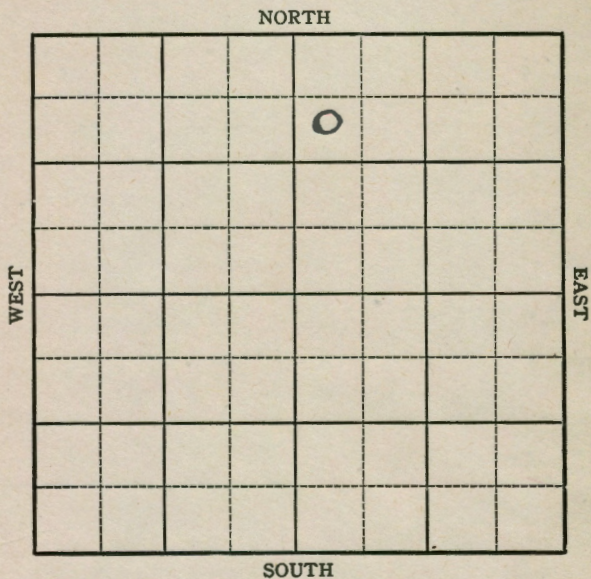

FORM 252-A
5M 3-44 PETROL

KANSAS

Cowley

Sec. 7 Twp. 34 R. 6E

Well No. #1 W. Kavanugh Farm

Continental Company

Miscellaneous


840 Ft. from N. Line

 Ft. from S. Line

 Ft. from E. Line

330 Ft. from W. Line

440. 1114

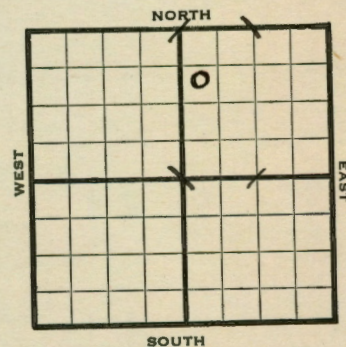

1944

REPORT

3/22 Location

3/29 "

4/5 Rotary

4/12 16" @ 27

10" @ 188

WOC.

4/19 Drlg. 2570'

4/26 Miss 2921

TD 2967

ABANDONED

Map No. 2 Sec. 7 Twp. 34 R. 6EWell No. 1 W. KavanughContinental

Company

FIRST REPORT

Contractor

SW NW NE

SECTION PLAT

840 Ft. from N. Line

Ft. from S. Line

Ft. from E. Line

330 Ft. from W. LineMiscellaneousLocation X

Rig up

Drilling and Remarks:

RECORD

Cased in, ft.

Sand

Gas

Oil

Total Depth

PRODUCTION

1st 24 hrs. Nat.

1st 24 hrs. after shot

Gas Cu. Ft.

Dry Hole

Abandoned

Date

MAR 22 1944 19S. J. LEWIS

Scout

Pool Name MiscellaneousMap No. 2 Sec. 7 Twp. 34 R. 6EWell No. 1 W. KavanughContinental

Company

ABANDONED

Contractor

SW NW NE

SECTION PLAT

840 Ft. from N. Line

Ft. from S. Line

Ft. from E. Line

330 Ft. from W. LineCowley County

Location

Rig up

Drilling and Remarks:

Miss 2921

RECORD

Cased in, ft.

Sand

Gas

Oil

Total Depth 2967

PRODUCTION

1st 24 hrs. Nat.

1st 24 hrs. after shot

Gas Cu. Ft.

Dry Hole

Abandoned

Date

APR 26 1944 19S. J. LEWIS Scout