



Sec. 6 Twp. 34 R. 6E

Well No. #3 Waldschmidt Farm

Continental Company


Miscellaneous

Ft. from N. Line

1230 Ft. from S. Line

990 Ft. from E. Line

Ft. from W. Line

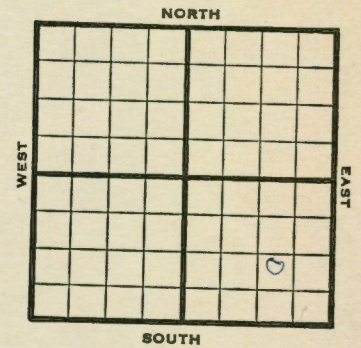


Section 6 Township 34 Range 6E

Well No. #3, Waldschmidt

Company Continental

NORTH

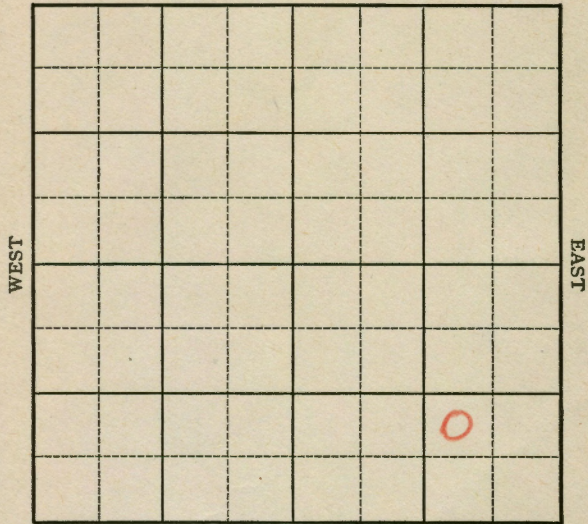

SOUTH

1946 Elev. 1116 REPORT

- 3/27 RUR
- 4/4 10" @ 160
Drlg. 1606'
- 4/10 Bart 2870
6" @ 2870 RUST
- 4/16 TD 2889-2000' oil
- 4/23 10 qts 2887-86
Flow & swab 110 oil 24 hrs
- 5/1 " " "
- 5/7 " " "
- 5/15 Bart. 2870
6" @ 2870
TD 2889
10 qts. 2881-2886
Flow 149 Pot.
Grav. 39.0

COMPLETED

KANSAS Kansas Pool Name Miscellaneous
Map No. 2 Sec. 6 Twp. 34 R. 6E
Well No. 3 Waldschmidt

Continental Company
COMPLETED Contractor

NW SE SE

SECTION PLAT

 Ft. from N. Line
1230 Ft. from S. Line
990 Ft. from E. Line
 Ft. from W. Line

			o

Cowley County

Location _____
Rig up _____
Drilling and Remarks:
Salt 2570
6" @ 2870
109 to 2881-86
Flow 149 bbl
89° 9'

RECORD

Cased _____ in., _____ ft.
Sand _____
Gas _____
Oil _____
Total Depth 2887

PRODUCTION

1st 24 hrs. Nat. _____
1st 24 hrs. after shot _____
Gas _____ Cu. Ft.
Dry Hole _____
Abandoned _____

Date
MAY 15 1946 19 _____

S. J. LEWIS Scout

KANSAS Kansas Pool Name Miscellaneous
Map No. 2 Sec. 6 Twp. 34 R. 6E
Well No. 3 Waldschmidt

Continental Company
FIRST REPORT Contractor

SECTION PLAT

 Ft. from N. Line
1230 Ft. from S. Line
990 Ft. from E. Line
 Ft. from W. Line

			o

Cowley County

Location _____
Rig up _____
Drilling and Remarks:
RUR

RECORD

Cased _____ in., _____ ft.
Sand _____
Gas _____
Oil _____
Total Depth _____

PRODUCTION

1st 24 hrs. Nat. _____
1st 24 hrs. after shot _____
Gas _____ Cu. Ft.
Dry Hole _____
Abandoned _____

Date
MAR 27 1946 19 _____

S. J. LEWIS Scout