

KANSAS


FORM 51 5M PETROL

Cowley

Section 6 Township 34 Range 6-E

Well No. #1 M. Waldschmidt

Company Summit Drlg.

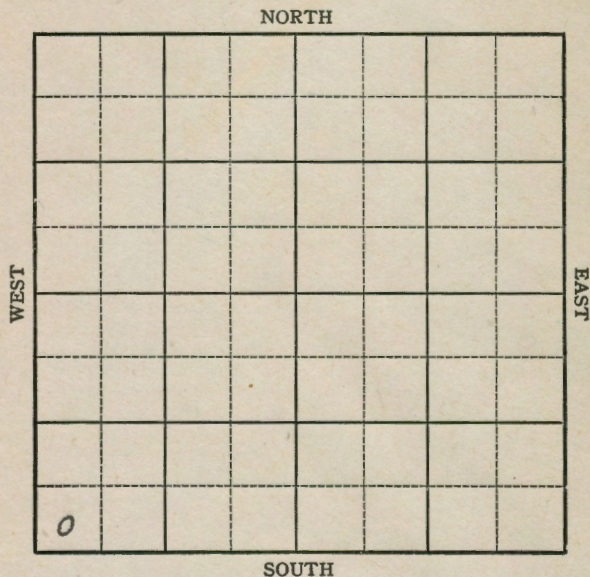

KANSAS
FORM 252-A
5M 9-43 GASS

Cowley

Sec. 6 Twp. 34 R. 6-E

Well No. #1 M. Waldschmidt Farm


Summit Drlg. Company

 Ft. from N. Line

330 Ft. from S. Line

 Ft. from E. Line

330 Ft. from W. Line

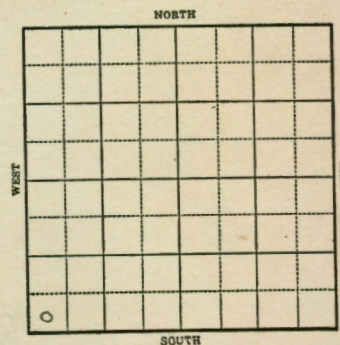

1943

R E P O R T

12-22 Rotary

12/29 8" @ 55' WOC

1944

1-5 10" @ 45 Corrected

Drlg 2840'

1-12 " "

1/19 Miss 3017

TD 3028'

ABANDONED

KANSAS
Map No. 2 Sec. 6 Twp. 34 R. 6EWell No. 1 M. Waldschmidt

Summit Drlg. _____ Company

ABANDONED _____ Contractor

SW/C

SECTION PLAT

_____ Ft. from N. Line

330 Ft. from S. Line

_____ Ft. from E. Line

330 Ft. from W. Line

Miscellaneous

Location _____

Rig up _____

Drilling and Remarks:

Miss 3017

RECORD

Cased _____ in., _____ ft.

Sand _____

Gas _____

Oil _____

Total Depth 8038

PRODUCTION

1st 24 hrs. Nat. _____

1st 24 hrs. after shot _____

Gas _____ Cu. Ft.

Dry Hole _____

Abandoned _____

Date

JAN 1 9 1944 19

S. J. LEWIS Scout

KANSAS
Map No. 2 Sec. 6 Twp. 34 R. 6EWell No. 1 M. Waldschmidt

Summit Drlg. _____ Company

FIRST REPORT _____ Contractor

SW/C

SECTION PLAT

_____ Ft. from N. Line

330 Ft. from S. Line

_____ Ft. from E. Line

330 Ft. from W. Line

Miscellaneous

Location _____

Rig up _____

Drilling and Remarks:

Rotary

RECORD

Cased _____ in., _____ ft.

Sand _____

Gas _____

Oil _____

Total Depth _____

PRODUCTION

1st 24 hrs. Nat. _____

1st 24 hrs. after shot _____

Gas _____ Cu. Ft.

Dry Hole _____

Abandoned _____

Date

DEC 2 2 1943 19

S. J. LEWIS Scout