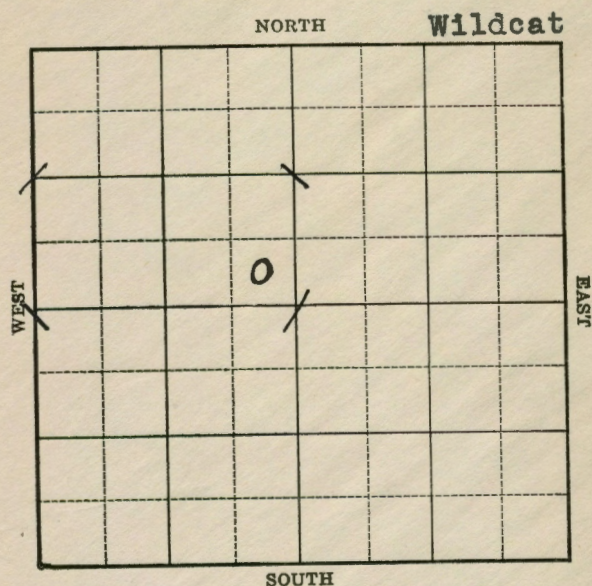



Cowley **KANSAS**Section 2 Township 34 Range 6-EWell No. #1 GregoryCompany Western Kansas Oil & Refg. et alSec. 2 Twp. 34 R. 6EWell No. #1 Gregory FarmWestern Kansas Oil & Refg. et al Company

(Wildcat)

Ft. from N. Line

330 Ft. from S. Line330 Ft. from E. Line

Ft. from W. Line

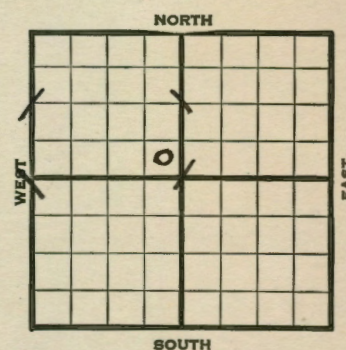**Elev. 1285'**

1939	REPORT
6/7	Cable rig
6/16	"
6/23	"
6/29	"
7/6	"
7/13	"
7/20	Drlg. 340'
7/27	1280' run 10".
8/3	12" - 517' 10" - 1280'
	T.D. 1550' U.R. 10".
8/10	10" - 1570' Drlg. 1712'
8/17	10" - 1700' Drlg. 1920'
8/24	10" - 2040' Drlg. 2355'
8/31	8 1/4" - 2417' Drlg. 2536'
9/6	Miss. 3095'
	T.D. 3113'
	H.F.W. 3109'
	ABANDONED

Cowley KANSAS

Map No. 2 Sec. 2 Twp. 34 R. 6EWell No. 1 Gregory

Western Kansas Oil & Refg. Company

Contractor

ABANDONED

SECTION PLAT


SE NW

Ft. from N. Line

330 Ft. from S. Line330 Ft. from E. Line

Ft. from W. Line

WILDCAT

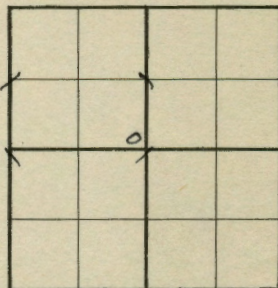

Location

RECORD

Cased _____ in., _____ ft.

Sand _____

Gas _____

Oil _____

Total Depth 3113

PRODUCTION

1st 24 hrs. Nat. _____

1st 24 hrs. after shot _____

Gas _____ Cu. Ft.

Dry Hole _____

Abandoned _____

Date

SEP 6 1939₁₉

S. J. LEWIS Scout

KANSAS

Cowley

Map No. 2 Sec. 2 Twp. 34 R. 6EWell No. 1 GregoryWestern Kansas Oil & Refg. ^{etal} Company

Contractor

FIRST REPORT

SECTION PLAT


SE NW

Ft. from N. Line

330 Ft. from S. Line330 Ft. from E. Line

Ft. from W. Line

WILDCAT

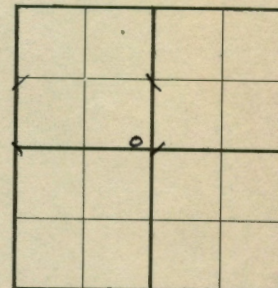

Location

RECORD

Cased _____ in., _____ ft.

Sand _____

Gas _____

Oil _____

Total Depth _____

PRODUCTION

1st 24 hrs. Nat. _____

1st 24 hrs. after shot _____

Gas _____ Cu. Ft.

Dry Hole _____

Abandoned _____

Date

JUN 7 1939₁₉

S. J. LEWIS

Scout