

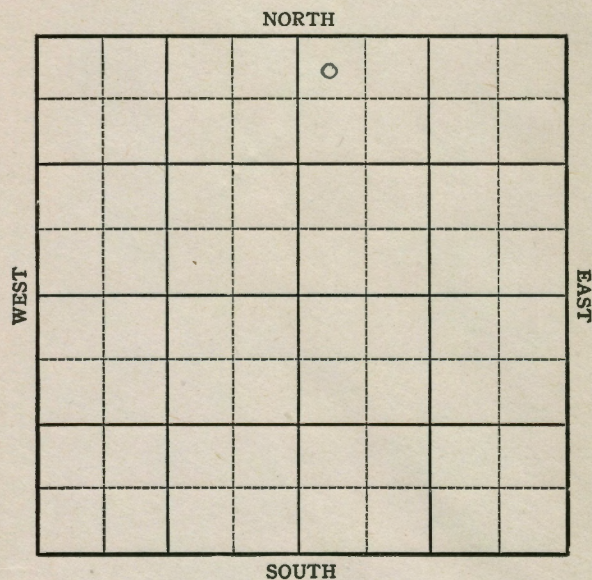
KANSAS

Cowley

FORM 252-A
5M 9-43 GASS

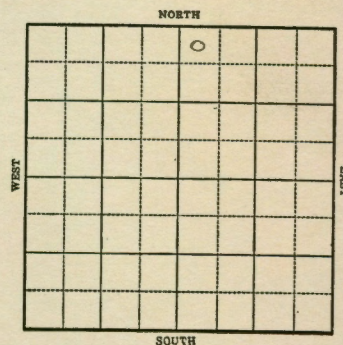
Cowley

FORM 51 5M PETROL

Section 3 Township 34 Range 6-EWell No. #1 R. N. DavisCompany ContinentalSec. 3 Twp. 34 R. 6 EWell No. #1 R. N. Davis FarmContinental Company330 Ft. from N. Line

Ft. from S. Line

Ft. from E. Line

330 Ft. from W. Line*Eden - 1190*

1943

REPORT

12-8	Location
12-15	"
12/22	Derrick
12/29	"
1944	
1-5	Rotary
1-12	12" @ 27
	TD 226 Run 10"
1/19	10" @ 143
	Drlg. 1175
1/26	Drlg. 2775'
2/2	Miss 3078
	TD 3185

COMPLETED

Map No. 2 Sec. 3 Twp. 34 R. 6EWell No. 1 R. N. Davis

Continental

Company

FIRST REPORT

Contractor

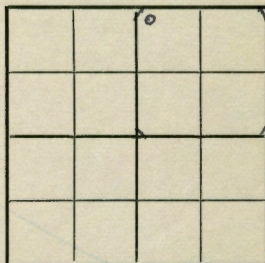
NW NE

SECTION PLAT

330 Ft. from N. Line

Ft. from S. Line

Ft. from E. Line

330 Ft. from W. Line

Miscellaneous

Location X

Rig up

Drilling and Remarks:

RECORD

Cased in, ft.

Sand

Gas

Oil

Total Depth

PRODUCTION

1st 24 hrs. Nat.

1st 24 hrs. after shot

Gas Cu. Ft.

Dry Hole

Abandoned

Date

DEC 8 1943 19 S. J. LEWIS Scout

Map No. 2 Sec. 3 Twp. 34 R. 6EWell No. 1 R. N. Davis

Continental

Company

ABANDONED

Contractor

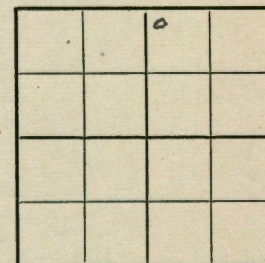
NW NE

SECTION PLAT

330 Ft. from N. Line

Ft. from S. Line

Ft. from E. Line

330 Ft. from W. Line

Miscellaneous

Location

Rig up

Drilling and Remarks:

Miss 3078

RECORD

Cased in, ft.

Sand

Gas

Oil

Total Depth 8185

PRODUCTION

1st 24 hrs. Nat.

1st 24 hrs. after shot

Gas Cu. Ft.

Dry Hole

Abandoned

Date

FEB 2 1944 19 S. J. LEWIS Scout