


Map No. **KANSAS** Sec. 4 Twp. 34 R. 6E
 Well No. 1-Esch Farm
Statchorn O. G. Company

NORTH

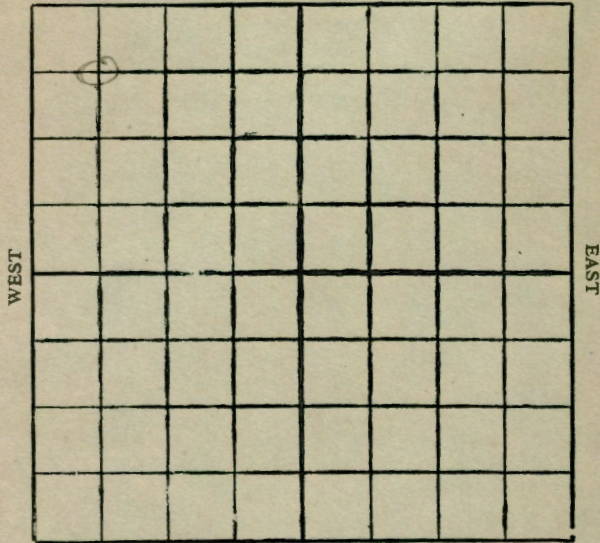

SOUTH

Location _____
 Drilling Remarks _____

Rig Up _____
 Drilling Remarks _____

RECORD

Cased _____ in. _____ ft.
 Sand _____
 Gas _____
 Oil _____
 Total Depth _____

PRODUCTION

1st 24 hrs. Nat. _____
 1st 24 hrs. after shot _____
 Gas _____ cu. ft.
 Dry Hole _____
 Abandoned _____

Map No. **KANSAS** Sec. 4 Twp. 34 R. 6E
 Well No. 1-Esch Farm
Statchorn O. G. Company


NORTH

660 Ft. from N. Line

_____ Ft. from S. Line

_____ Ft. from E. Line

660 Ft. from W. Line

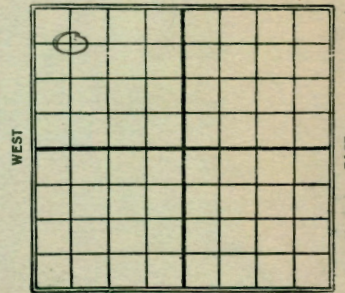

SOUTH

1928

Date

REPORT

2/23 Rigging up
 3/1 Spudding -
 3/8 Drlg-315
 3/15 Dry 465-469
 T.D. 770
 Aband. 770

2 **KANSAS** Sec. 4 Twp. 34 R. 6

Well No. 1 Esch

Watchorn Oil Co. Company

Contractor

COMPLETED

SECTION PLAT

660 Ft. from N. Line

Ft. from S. Line

Ft. from E. Line

660 Ft. from W. Line

ABANDONED

0			

Location

Rig up

Drilling and Remarks:

660 770

RECORD

Cased in. ft.

Sand Dry 465-469

Gas

Oil

Total Depth 770

PRODUCTION

1st 24 hrs. Nat.

1st 24 hrs. after shot.

Gas Cu. Ft.

Dry Hole

Abandoned

Date

MAR 15 1928

CHAS. L. SHERWOOD

192

Scout

2 **KANSAS** Sec. 4 Twp. 34 R. 6

Well No. 1 Esch

Watchorn Oil Co. Company

Contractor

FIRST REPORTS

SECTION PLAT

660 Ft. from N. Line

Ft. from S. Line

Ft. from E. Line

660 Ft. from W. Line

0			

Location

Rig up

Drilling and Remarks:

Rigging up

RECORD

Cased in. ft.

Sand

Gas

Oil

Total Depth

PRODUCTION

1st 24 hrs. Nat.

1st 24 hrs. after shot.

Gas Cu. Ft.

Dry Hole

Abandoned

Date

FEB 23 1928

CHAS. L. SHERWOOD

192

Scout