


KANSAS

Cowley
 Section 1 Township 34 Range 6E
 Well No. #1 Adams
 Company L. O. Slocum

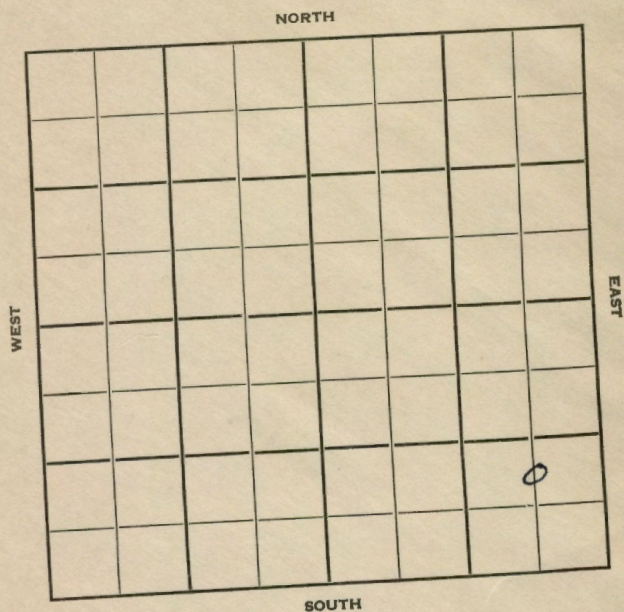


Cowley

KANSAS

Sec. 1 Twp. 34 R. 6E
 Well No. #1 Adams Farm
L. O. Slocum Company
 Contractor

600 Ft. from N. Line
~~900~~ Ft. from S. Line
900
~~600~~ Ft. from E. Line
 Ft. from W. Line
 C ^W N L SE SE

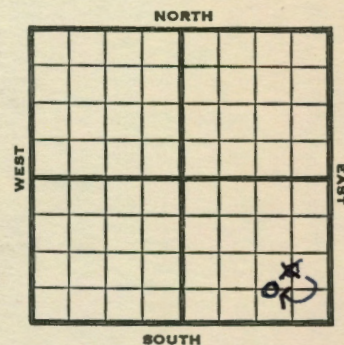

1953 Elev. 1235' REPORT

3/18 13" @ ?
 5/13 Spud 3-20-53
 8" @ 92 TD 1976
 D & A

ABANDONED

County Cowley State Kansas
 Sec. 1 (Blk. 34 (Sur. 6E Map No.
 Operator L. O. Slocum
 Well No. 1 Farm Adams
 Elev. 1235 Location C W L SE SE




600 Ft. From S Line SE
 900 Ft. From E Line Quarter
 1st. Report
 Completion MAY 13 1953
 Remarks
 Spudding Date 3-20-53

Drig. Data

8" @ 92 TD 1976 D & A

J. G. McGEHEE

County Cowley State Kansas
 Sec. 1 (Blk. 34 (Sur. 6E Map No.
 Operator L. O. Slocum
 Well No. 1 Farm Adams
 Elev. Location C W L SE SE

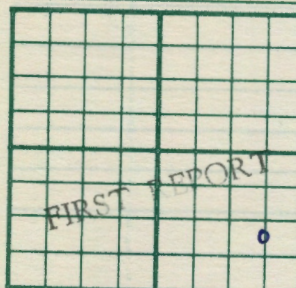

900 Ft. From S Line SE
 600 Ft. From E Line Quarter
 1st. Report MAR 18 1953
 Completion
 Remarks
 Spudding Date

Drig. Data

13" @

J. G. McGEHEE

Map No. _____ Sec. 1 Twp. 34 R. 6EWell No. 1 AdamsL. O. Slocum

Company _____

CORRECTION

Contractor _____

C W L SE SE

SECTION PLAT

	X		o

_____ Ft. from N. Line

600 Ft. from S. Line900 Ft. from E. Line

_____ Ft. from W. Line

Cowley County

Location _____

Rig up _____

Drilling and Remarks:

ReportedCNL SE SE

RECORD

Cased _____ in., _____ ft.

Sand _____

Gas _____

Oil _____

Total Depth _____

PRODUCTION

1st 24 hrs. Nat. _____

1st 24 hrs. after shot _____

Gas _____ Cu. Ft.

Dry Hole _____

Abandoned _____

Date

APR 1 1953

19

J. G. McGEHEE Scout