
FORM 51 25M 8-50 WESTERN Cowley KANSAS

Section 1 Township 34 Range 6 E

Well No. # 1 Adams

Company Foster & Slocum

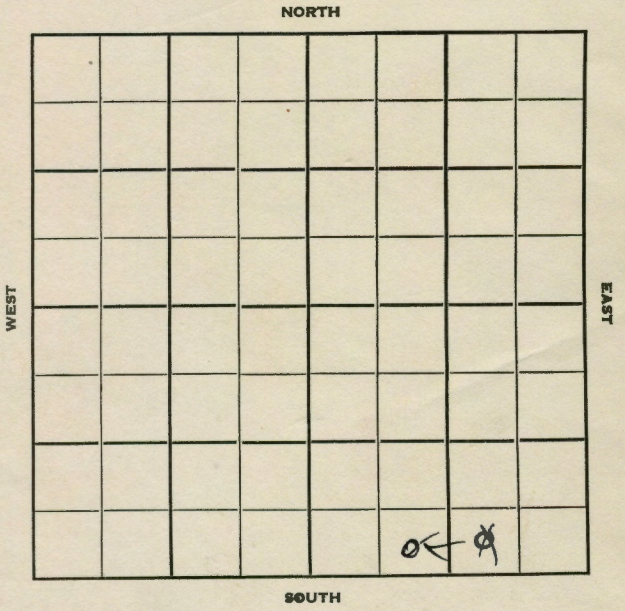

10M 11-50 PETROL Cowley KANSAS

Sec. 1 Twp. 34 R. 6E

Well No. #1 Adams Farm

Foster & Slocum Company

Contractor


Ft. from N. Line

330' Ft. from S. Line

~~990'~~ Ft. from E. Line

990' Ft. from W. Line

SE SW SE ~~SW SE SE~~

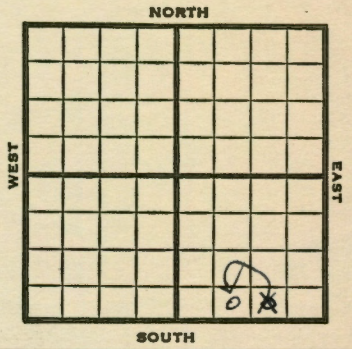

1951	Elev. 1294' REPORT
3/21	RUR
7/3	Spud 4-2-51 D&A TD 3200 12 @ 750' 10" @ 1180 8" @ 1582 Layton 2225' Bart 2535' Sand 2460' Gas 2490-95' Chat 2800 Miss 2818' Arb. 3145' TD 3200 PB 1828 5 bopd 7"@ 1818 Hydrafrac D&A ABANDONED

FORM 275 FOR SALE BY KANSAS BLUE PRINT CO.


County Cowley State Kansas

Sec. 1 (Blk. Twp.) 34 (Sur. Rge.) 6 E Map No.

Operator Foster & Slocum

Well No. 1 Farm Adams

Elev. 1294 Location SE SW SE

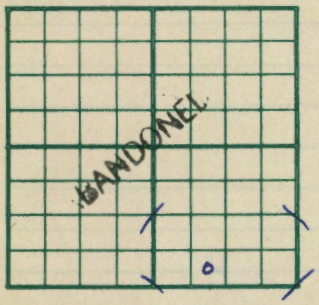

330 Ft. From S Line SE

990 Ft. From W Line Quarter

1st. Report

Completion JUL 3 1951

Remarks

Spudding Date 4-2-51

Drlg. Data D & A TD 3200

12" @ 750 10" @ 1180 8" @ 1582

Layton 2225 Bart. 2535 Sand 2460

Gas 2490-95 Chat 2800 Miss. 2818

Arb. 3145 TD 3200 PB 1828 5 bopd

7" @ 1818 Hydrofrac

D & A

J. E. TYRA

FORM 275 FOR SALE BY KANSAS BLUE PRINT CO.


County Cowley State Kansas

Sec. 1 (Blk. Twp.) 34 (Sur. Rge.) 6E Map No.

Operator Foster & Slocum

Well No. 1 Farm Adams

Elev. Location SW SE SE

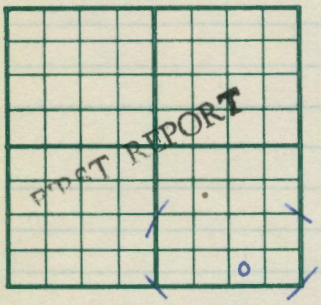

330 Ft. From S Line SE

990 Ft. From E Line Quarter

1st. Report MAR 21 1951

Completion

Remarks

Spudding Date

Drlg. Data

RUN

J. E. TYRA

Form 26 200 Bks. 8-50 Petrol

Kansas

Map No. _____ Sec. 1 Twp. 34 R. 6E


Well No. 1 Adams

Foster & Slocum Company

_____ Contractor

SE SW SE

SECTION PLAT

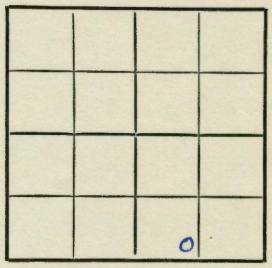

_____ Ft. from N. Line

330 Ft. from S. Line

_____ Ft. from E. Line

990 Ft. from W. Line

Cowley County

Location _____

Rig up _____

Drilling and Remarks:

Reported

SW SE SE

RECORD

Cased _____ in., _____ ft.

Sand _____

Gas _____

Oil _____

Total Depth _____

PRODUCTION

1st 24 hrs. Nat. _____

1st 24 hrs. after shot _____

Gas _____ Cu. Ft.

Dry Hole _____

Abandoned _____

Date

APR 4 1951 19 J. E. TYRA Scout