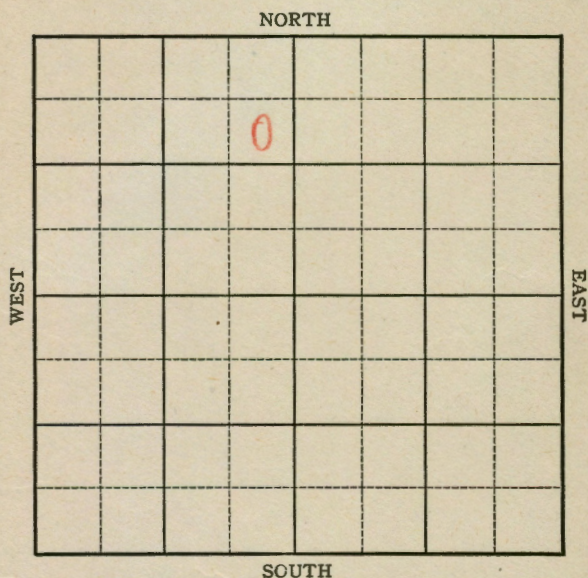


KANSAS

Cowley county

Section 5 Township 34 Range 6EWell No. #2, E. CoxCompany Continental

KANSAS

Cowley County

Sec. 5 Twp. 34 R. 6EWell No. #2 E. Cox Farm _____

Continental Company

Miscellaneous


920 Ft. from N. Line

_____ Ft. from S. Line

540 Ft. from E. Line

_____ Ft. from W. Line

SE NE NW

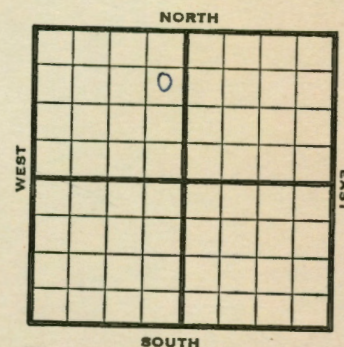

1946

Elev 1118' REPORT

4/10 Location

4/16 RUR

4/23 10" @ 173
Drlg 690

5/1 Bart 2845-
TD 2858
Run 6"

5/7 6" @ 2845 RUSt

5/14 " " "

5/21 TD 2878'
Flow 90 oil 24 hrs

5/29 Bart 2845'
6" @ 2845
Flow 122 Pot
TD 2878'
37.0 Gr.

COMPLETED

KANSASKansas Pool Name MiscellaneousMap No. 2 Sec. 5 Twp. 34 R. 6EWell No. 2 E. CoxContinental

Company

COMPLETED

Contractor

SE NE NW

SECTION PLAT

920 Ft. from N. Line Ft. from S. Line540 Ft. from E. Line Ft. from W. LineCowley County

Location

Rig up

Drilling and Remarks:

Box 25456" 02545Flow 122 02587° 34'

Date

MAY 29 1946

19

S. J. LEWIS

Scout

RECORDCased in., ft.Sand Gas Oil Total Depth 2875**PRODUCTION**1st 24 hrs. Nat. 1st 24 hrs. after shot Gas Cu. Ft.Dry Hole Abandoned **KANSAS**Kansas Pool Name MiscellaneousMap No. 2 Sec. 5 Twp. 34 R. 6EWell No. 2 E. CoxContinental

Company

FIRST REPORT

Contractor

SE NE NW

SECTION PLAT

920 Ft. from N. Line Ft. from S. Line540 Ft. from E. Line Ft. from W. LineCowley CountyLocation XRig up

Drilling and Remarks:

RECORDCased in., ft.Sand Gas Oil Total Depth **PRODUCTION**1st 24 hrs. Nat. 1st 24 hrs. after shot Gas Cu. Ft.Dry Hole Abandoned

Date

APR 10 1946

19

S. J. LEWIS

Scout