


Cowley

KANSAS

SECTION 5 TOWNSHIP 34 RANGE 6 E

WELL NO. #2 Lester

COMPANY E. G. Bradley

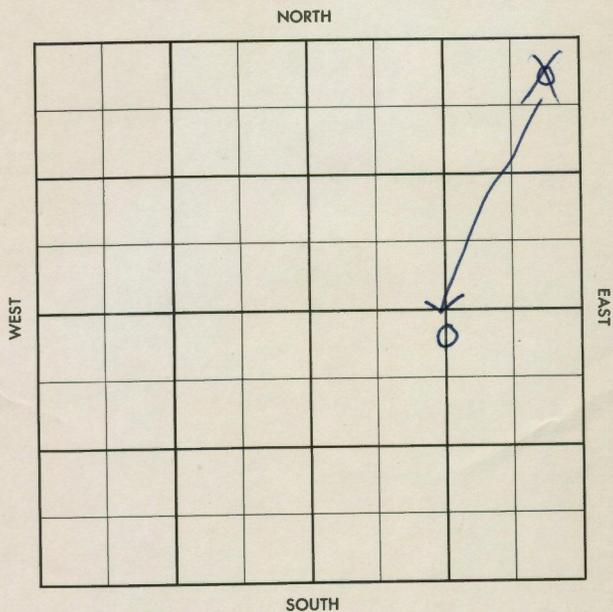

Cowley

KANSAS

SEC. 6 TWP. 34 R. 6E

WELL NO. #2 Lester FARM

COMPANY E.G. Bradley

CONTRACTOR McKnab & Lindsey


Cabin Valley

\_\_\_\_\_ Ft. from N. Line

\_\_\_\_\_ Ft. from S. Line

\_\_\_\_\_ Ft. from E. Line

\_\_\_\_\_ Ft. from W. Line

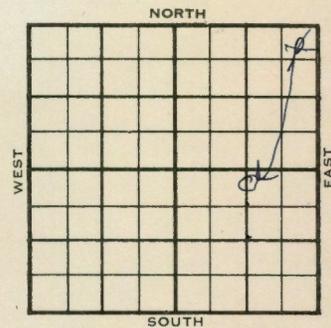

NE NE NE  
C N 1/2 N 1/2 SE

1956	ELEVATION	REPORT
1-25	MIR	
2-1	Comm. 1-24-56 8 5/8" @ 105/100 Cored 1783-1803, full rec. Cored. 2210-55 full rec. D & A Stal. 1786 Layton 2230 TD 2255	

ABANDONED

DX-78

FORM 513 REV. SUNRAY

County ~~Cowley~~ Elev.   
 Sec. ~~6~~ Twp. ~~34~~ Rgs. ~~6E~~   
 Company ~~E. G. Bradley~~   
 FarmName ~~Lester~~ No. ~~2~~

TOPS	DEPTH	LOG	DATUM	Loc. in Sec.
				C N $\frac{1}{2}$ N $\frac{1}{2}$ SE
Anh.				
TP.				
H. <i>Stal</i>	1786			
Tr.				
Dg. <i>Layton</i>	2230			
BL.				
L.				
K.C.				
B.K.C.				
Ce.				
C.				
M.				
M.				
K.				
Mz.				
Ma.				
V.				
S.				
S.				
A.				
R.				
PE.				
G.				
TD.	2255			

Geol.   
 Contr   
 McKnab & Lindsay   
 Pool   
 Cabin Valley



Date Comm. 1-24-56   
 8 5/8" @ 105/100 Cored 1783-1803   
 full rec. Cored 2210-55 full rec.


D & A

FORM 513 REV. SUNRAY

County ~~Cowley~~ Elev.   
 Sec. ~~5~~ Twp. ~~34~~ Rgs. ~~6E~~   
 Company ~~E. G. Bradley~~   
 FarmName ~~Lester~~ No. ~~2~~

TOPS	DEPTH	LOG	DATUM	Loc. in Sec.
Anh.				NE NE NE
TP.				
H.				
Tr.				
Dg.				
BL.				
L.				
K.C.				
B.K.C.				
Ce.				
C.				
M.				
M.				
K.				
Mz.				
Ma.				
V.				
S.				
S.				
A.				
R.				
PE.				
G.				
TD.				

Geol.   
 Contr   
 McKnab & Lindsay   
 Pool   
 Cabin Valley

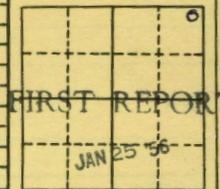

Date Comm.   
 M I R

