


Cowley
KANSAS
SECTION 5 TOWNSHIP 34 RANGE 6E
WELL NO. #18 Rahn Unit #1
COMPANY Continental

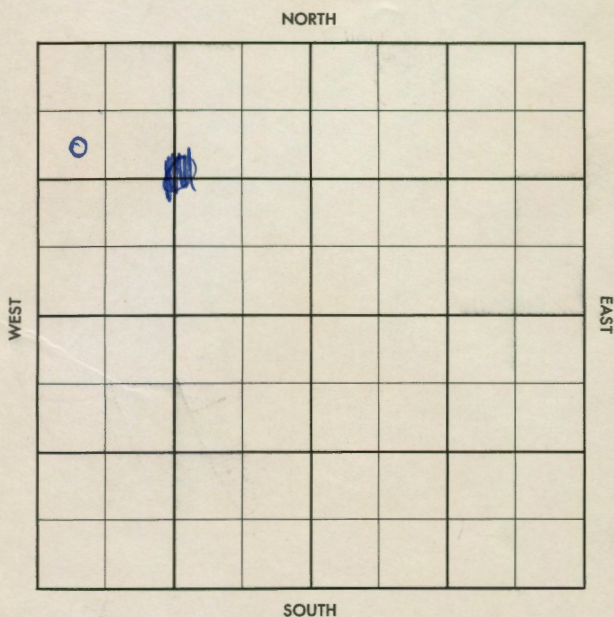


FORM 504-3 SUNRAY

Cowley
KANSAS
SEC. 5 TWP. 34 R. 6E
WELL NO. #18 Rahn Unit #1 FARM
COMPANY Continental
CONTRACTOR

Cabin Valley

_____ FT. FROM N. LINE
_____ FT. FROM S. LINE
_____ FT. FROM E. LINE
_____ FT. FROM W. LINE

SW NW NW

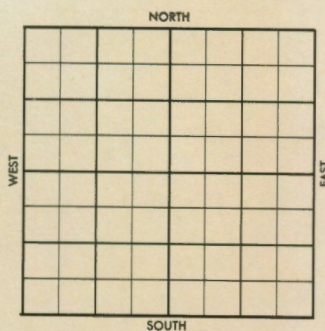

1956 ELEVATION **1117** REPORT

5-23 Location
6-27 S 5-25 8 148/150 Sx., 4½ 2169/190 Sx.
Perf 126/2113-16
\$ Lac. rec load, Refrac
\$ Load & tite to acq.
\$ 72 PF 128/6107-10, Frac. 500/500',
lost load, sqz., CO to PF 2110-16
Sq all PFs, CO 2130 24/2113-19 tst 5
GO / 1½ BW 2 hrs, Frac
\$ Ld., 1st ld 20/2121-26
\$ 1 BO / 27 BW 4 hrs
\$ 1/4 BOPH / 6 BWPH
\$ 40 BW / Trace oil
Lay 2110
TD: 2175
D & A

ABANDONED

FORM 504-5 SUNRAY

County Cowley Elev. 1117
 Sec. 5 Twp. 34 Rge. 6E
 Company Continental
 Farm Name Rahn Unit #1 No. 18

TOPS	DEPTH	LOG	DATUM	Loc. in Sec.
Anb.				SW NW NW
Tp. <u>low</u>	<u>2160</u>			
H.				
Tr.				
Dg.				
BL.				
L.				Geol.
K.C.				Contr.
B.K.C.				
Ce.				
C.				
M.				Pool
K.				Cabin Valley
Mz.				
Mo.				
V.				
S.				
A.				
R.				
PF.				
G.				
				ABANDONED
T.D.	<u>2175</u>			

Date Comm.

JUN 27 '56

Location MAY 29 '56 1830 JUN 6 '56
S 5-25-8 148/150 st
4 1/2 2164/100 st Ref 126 2113 st
Shore Rec. road, Rahn, 8 mi
3 mi to sec. JUN 13 '56 547 PF 126
Frac. 500/500 #, lost road, 542, CO
to PF 2160-16. JUN 20 '56 SQ 211 PFS
CO 2120 24/2113-19 tst 560
1 1/4 BW 2 mi FRAC & LD.

FORM 513-1 SUNRAY

5-34-6E SW NW NW

JAN 27 56 Lst Ld 20/21/21-26 \$

1 B0 + 27 BW 4 hrs \$ 44

Boph + 6 Bwph \$ 40 BW

+ Trace oil

D&A