


KANSAS

Cowley

Section 5 Township 34 Range 6E
 Well No. 1 E. Berry
 Company Continental

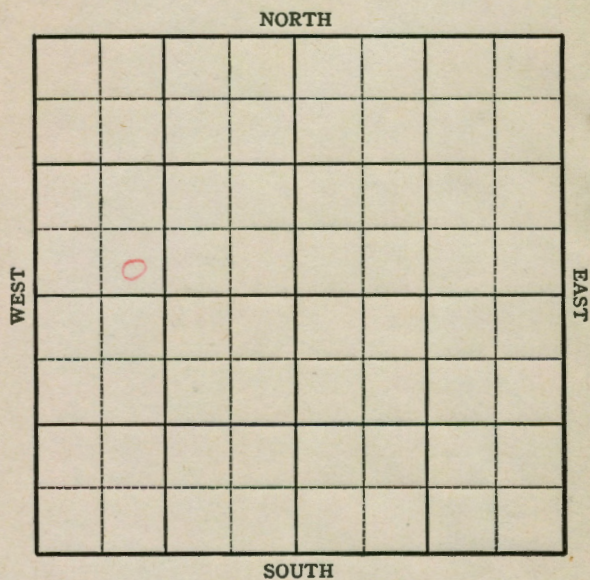

KANSAS

Cowley

Sec. 5 Twp. 34 R. 6-E
 Well No. #1 E. Berry Farm _____
Continental Company _____


_____ Ft. from N. Line

330 Ft. from S. Line

_____ Ft. from E. Line

890 Ft. from W. Line

SE SW NW

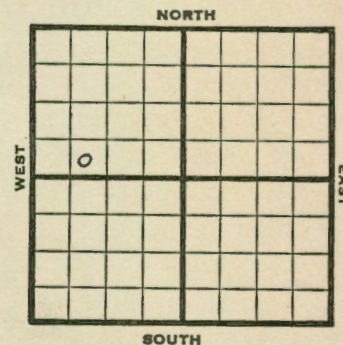1945 **Elev. 1122** REPORT

11/28 Location
 12/5 13" @ 180 WOC
 12/12 Drlg. 2050
 12/20 Bart 2851' T.D. 2881'
 8" - 2851' RUST.
 12/29 " " "
 1946
 1/10 Shot 40 qts. 2855-71'
 1800' oil.
 1/17 Swab 40 oil in 8 hours.
 1/24 Flow 120 oil 24 hours.
 1/31 " " "
 2/7 " " "
 2/14 " " "
 2/21 " " "
 2/28 " " "

3/6 **Bart. 2851**
 8" @ 2851
 TD 2881'
 Flow 102 Pot.
 Grav. 39.0

COMPLETED

KANSAS

Kansas Pool Name MiscellaneousMap No. 2 Sec. 5 Twp. 34 R. 6EWell No. 1 E. Berry

Continental Company

COMPLETED

Contractor

SE SW NW

SECTION PLAT

Ft. from N. Line

330 Ft. from S. Line

Ft. from E. Line

890 Ft. from W. Line

Cowley County

Location

Rig up

Drilling and Remarks:

Bar X2518" @ 251F 40 102 8X390 44

RECORD

Cased in., ft.

Sand

Gas

Oil

Total Depth 2887

PRODUCTION

1st 24 hrs. Nat.

1st 24 hrs. after shot

Gas Cu. Ft.

Dry Hole

Abandoned

Date

MAR 6 1946 19

S. J. LEWIS Scout

KANSAS

Kansas Pool Name MiscellaneousMap No. 2 Sec. 5 Twp. 34 R. 6EWell No. 1 E. Berry

Continental Company

FIRST REPORT

Contractor

SE SW NW

SECTION PLAT

Ft. from N. Line

330 Ft. from S. Line

Ft. from E. Line

890 Ft. from W. Line

Cowley County

Location X

Rig up

Drilling and Remarks:

RECORD

Cased in., ft.

Sand

Gas

Oil

Total Depth

PRODUCTION

1st 24 hrs. Nat.

1st 24 hrs. after shot

Gas Cu. Ft.

Dry Hole

Abandoned

Date

NOV 28 1945 19

S. J. LEWIS

Scout