


Sec. 5 Twp. 34 R. 6ESection 5 Township 34 Range 6EWell No. #3 CoxCompany Continental

NORTH

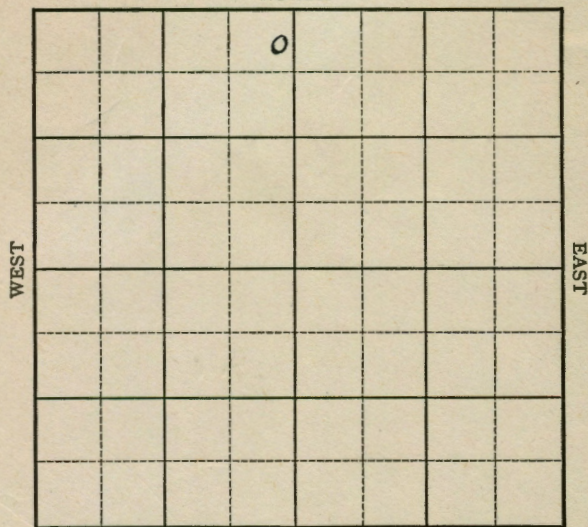

SOUTH

Well No. #3 Cox Farm _____
Continental Company

Misc.

410 Ft. from N. Line


_____ Ft. from S. Line

120 Ft. from E. Line

_____ Ft. from W. Line

NE NW

NORTH

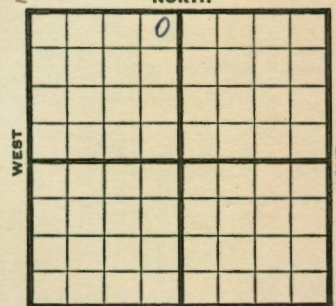

SOUTH

1946

Elev. 1123

REPORT

5/15

Location

5/21

Derrick

5/29

10" @ 188' WOC

6/5

Drlg. 2600

6/12

Bart 2851'

TD 2857'

6" @ 2851' RUST

6/18

TD 2880'

Swb 82 oil in 24 hrs.

6/26

20 qts 2865-75

Flow 110 oil in 10 hrs

7/3

Flow 35 oil in 3/4 hrs.

7/9

" " "

7/17

Bart 2851

6" @ 2851

20 qts. 2865-2875

TD 2880

Flow 191 Pot.

Grav. 39.0

COMPLETED

KANSAS Kansas Pool Name Miscellaneous
 Map No. 2 Sec. 5 Twp. 34 R. 6E
 Well No. 3 Cox

Continental Company
COMPLETED Contractor

NE NW

SECTION PLAT

410 Ft. from N. Line
 _____ Ft. from S. Line
120 Ft. from E. Line
 _____ Ft. from W. Line

		6	

Cowley County

Location _____

Rig up _____

Drilling and Remarks:

*Bar 42851**6" 2851**209 to 2865-95**Flow 191 BT**38 3/4*

RECORD

Cased _____ in. _____ ft.
 Sand _____
 Gas _____
 Oil _____
 Total Depth 2880

PRODUCTION

1st 24 hrs. Nat. _____
 1st 24 hrs. after shot _____
 Gas _____ Cu. Ft.
 Dry Hole _____
 Abandoned _____

Date

JUL 17 1946 19 S. J. LEWIS Scout

KANSAS

Kansas Pool Name Misc. *OK*
 Map No. _____ Sec. 5 Twp. 34 R. 6E
 Well No. 3 Cox

Continental Company

NE NW

FIRST REPORT

Contractor

SECTION PLAT

410 Ft. from N. Line
 _____ Ft. from S. Line
120 Ft. from E. Line
 _____ Ft. from W. Line

		0	

Cowley County

Location ✓

Rig up _____

Drilling and Remarks:

RECORD

Cased _____ in. _____ ft.
 Sand _____
 Gas _____
 Oil _____
 Total Depth _____

PRODUCTION

1st 24 hrs. Nat. _____
 1st 24 hrs. after shot _____
 Gas _____ Cu. Ft.
 Dry Hole _____
 Abandoned _____

Date

MAY 15 1946 19 S. J. LEWIS Scout