


KANSAS

Cowley

Section 5 Township 34 Range 6E
 Well No. 1 Waldschmidt
 Company H. B. Blair

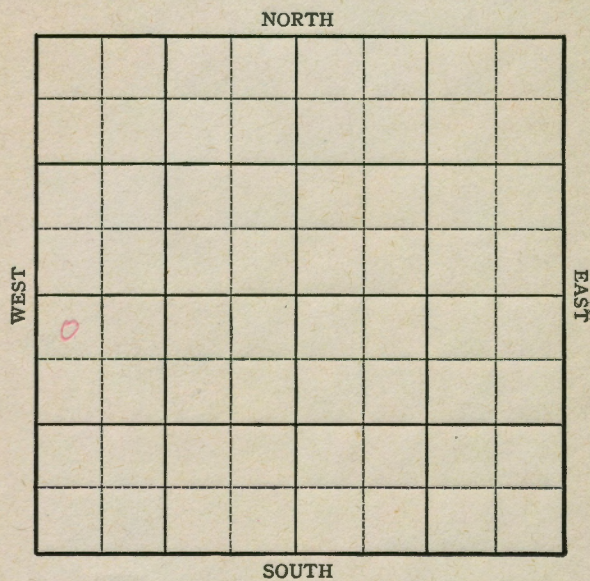


KANSAS

Cowley

Sec. 5 Twp. 34 R. 6E
 Well No. #1 Waldschmidt Farm
H.B. Blair Company

330 Ft. from N. Line
 _____ Ft. from S. Line
 _____ Ft. from E. Line
330 Ft. from W. Line

NW SW Elev. 1125

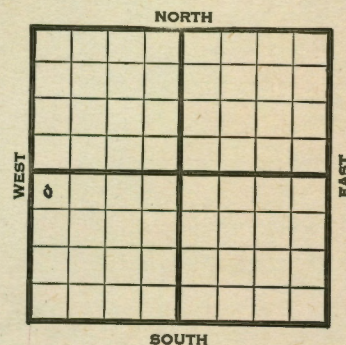

1945

REPORT

8/15 RUR
 8/22 10" @ 55'
 Drlg. 880
 8/29 **Sd 2125**
 Drlg. 2156
 9/5 **Bart. 2870-2879**
 TD 2885
 5" @ 2855 RUST
 9/12 " " "
 9/19 " " "
 9/26 Swab 3 oil per hr.
 10/3 " " "
 10/10 **Bart. 2870**
 5" @ 2855
 40 qts. 2870-2879
 TD 2885
 Flow 489 Pot.
 Grav. 38.0

COMPLETED

KANSAS


Pool Name MiscellaneousMap No. 2 Sec. 5 Twp. 34 R. 6EWell No. 1 WaldschmidtH. B. Blair Company

FIRST REPORT

Contractor

NW SW

SECTION PLAT

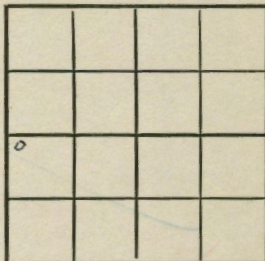330 Ft. from N. Line Ft. from S. Line Ft. from E. Line330 Ft. from W. LineCowley County

Location

Rig up

Drilling and Remarks:

RUR

RECORD

Cased in., ft.Sand Gas Oil Total Depth

PRODUCTION

1st 24 hrs. Nat. 1st 24 hrs. after shot Gas Cu. Ft.Dry Hole Abandoned

Date

AUG 15 1945

19

S. J. LEWIS

Scout

KANSAS


Pool Name MiscellaneousMap No. 2 Sec. 5 Twp. 34 R. 6EWell No. 1 WaldschmidtH. B. Blair Company

COMPLETED

Contractor

NW SW

SECTION PLAT

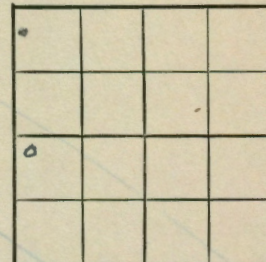330 Ft. from N. Line Ft. from S. Line Ft. from E. Line330 Ft. from W. LineCowley County

Location

Rig up

Drilling and Remarks:

Bar 28705" 2875419 to 2870-79F low 489 ft35' 9"

RECORD

Cased in., ft.Sand Gas Oil Total Depth 2875

PRODUCTION

1st 24 hrs. Nat. 1st 24 hrs. after shot Gas Cu. Ft.Dry Hole Abandoned

Date

OCT 10 1945

19

S. J. LEWIS

Scout