



Section 6 Township 34 Range 6-E
 Well No. #1 Lester
 Company B. B. Blair etal

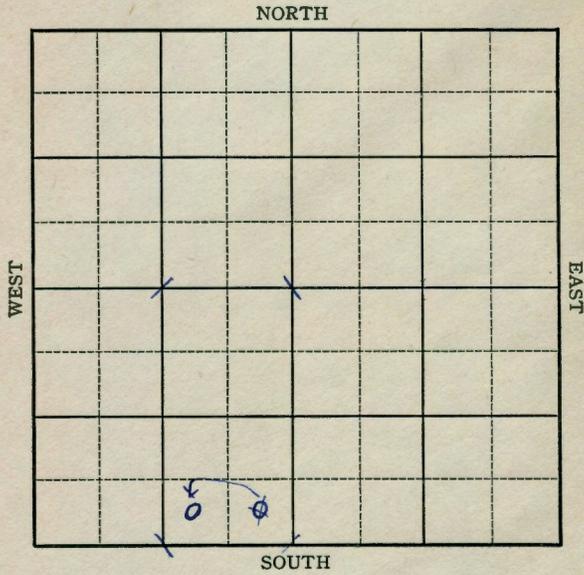

Sec. 6 Twp. 34 R. 6-E
 Well No. #1 Lester Farm _____
 Company B. B. Blair etal

_____ Ft. from N. Line
330 Ft. from S. Line
~~330~~ Ft. from E. Line
 _____ Ft. from W. Line
 Elev. 1113

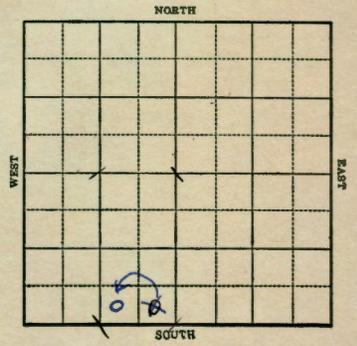

1943		REPORT
9/22	Location	
9/29	"	
10/6	"	
10/13	10" @ 48' Drlg. 193'	
10/20	KC 2532 Drlg. 2567	
10/27	Chab 2926 2926 Miss 2958 T.D. 2959 5" @ 2927 Rust	
11/3	T.D. 2959 5 qts 2947-57 10 qts 2946-56 VSSO 1 bailer water.	
11/10	Miss 2958 5" @ 2927 T.D. 2959' 15 qts 2946-57 Water SD	
		ABANDONED

KANSAS

Map No. 2 Sec. 6 Twp. 34 R. 6E

Well No. 1 Lester

B. B. Blair et al. Company

FIRST REPORT Contractor

SE SW


SECTION PLAT

_____ Ft. from N. Line

330 Ft. from S. Line

330 Ft. from E. Line

_____ Ft. from W. Line

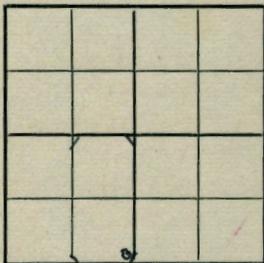

Miscellaneous

Location X

Rig up _____

Drilling and Remarks:

RECORD

Cased _____ in., _____ ft.

Sand _____

Gas _____

Oil _____

Total Depth _____

PRODUCTION

1st 24 hrs. Nat. _____

1st 24 hrs. after shot _____

Gas _____ Cu. Ft.

Dry Hole _____

Abandoned _____

Date

SEP 22 1943 19

S. J. LEWIS Scout

KANSAS

Map No. _____ Sec. 6 Twp. 34 R. 6E

Well No. 1 Lester

B. B. Blair et al. Company

ABANDONED Contractor

SW SE SW


SECTION PLAT

_____ Ft. from N. Line

330 Ft. from S. Line

990 Ft. from E. Line

_____ Ft. from W. Line

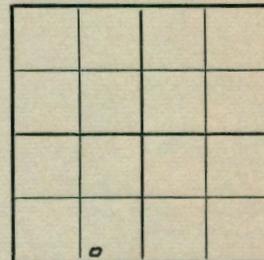

Miscellaneous

Location _____

Rig up _____

Drilling and Remarks:

Misc 2958
3" C2927
1596 2946 57
Water 80

RECORD

Cased _____ in., _____ ft.

Sand _____

Gas _____

Oil _____

Total Depth 2959

PRODUCTION

1st 24 hrs. Nat. _____

1st 24 hrs. after shot _____

Gas _____ Cu. Ft.

Dry Hole _____

Abandoned _____

Date

NOV 10 1943 19

S. J. LEWIS Scout

Cowley

KANSAS

Map No. 2 Sec. 6 Twp. 34 R. 6E

Well No. 1 Lester


B.B. Blair etal. Company

CORRECTION Contractor

SW SE SW

SECTION PLAT

_____ Ft. from N. Line
330 Ft. from S. Line
990 Ft. from E. Line
_____ Ft. from W. Line

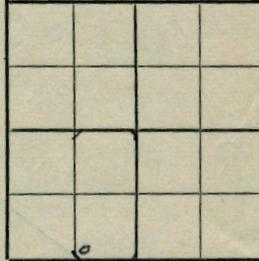

Miscellaneous

Location _____

Rig up _____

Drilling and Remarks:

Reported

SE SW

RECORD

Cased _____ in., _____ ft.

Sand _____

Gas _____

Oil _____

Total Depth _____

PRODUCTION

1st 24 hrs. Nat. _____

1st 24 hrs. after shot _____

Gas _____ Cu. Ft.

Dry Hole _____

Abandoned _____

Date

OCT 13 1943 19

S. J. LEWIS Scout