


SECTION 8 TOWNSHIP 34 RANGE 6E

WELL NO. #3 Waldschmidt

COMPANY Crest Petr. Co.

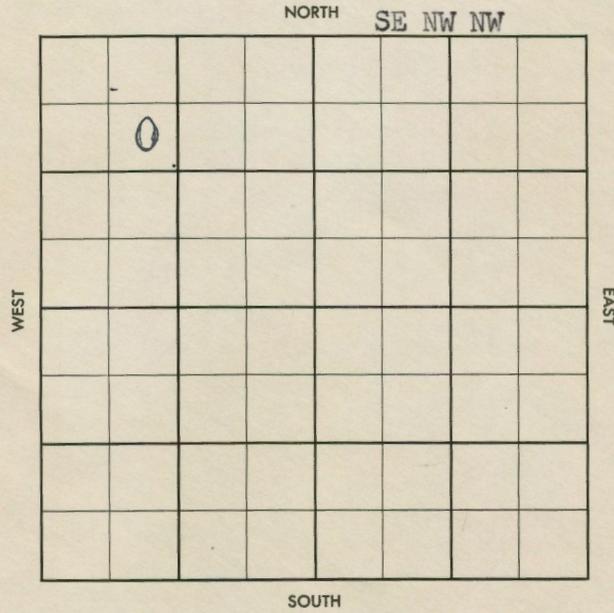

County Cowley Elev. 1203
Sec. 8 Twp. 34 Rgn. 6E
Company Crest Pet. Co.
Farm Name Waldschmidt No. 3

| TOPS | DEPTH | LOG | DATUM | Loc. in Sec. |
|------------------|-------------|-----|-------|---------------------|
| Anh. | | | | |
| Tp. <u>Elgin</u> | <u>1222</u> | | | <u>SE NW NW</u> |
| H. | | | | |
| Tr. | | | | |
| Dg. | | | | |
| Bl. | | | | |
| L. | | | | |
| K.C. | | | | Geol. |
| B.K.C. | | | | Contr. |
| Ce. | | | | <u>Wrico Drlg.</u> |
| C. | | | | |
| M. | | | | Pool |
| M. | | | | <u>Cabin Valley</u> |
| K. | | | | |
| Mz. | | | | |
| Ma. | | | | |
| V. | | | | |
| S. | | | | |
| S. | | | | |
| A. | | | | |
| R. | | | | |
| Pe. | | | | |
| G. | | | | |
| T.D. | <u>1304</u> | | | |

MAR 13 '57
ABANDONED

Date Comm. 3-4-57 13 57 8 1/8 78/60
TD 1304 4 1/4 1228/400
SW QW

County Cowley Elev. _____
Sec. 8 Twp. 34 Rgn. 6E
Company Crest Pet. Co.
Farm Name Waldschmidt No. 3

| TOPS | DEPTH | LOG | DATUM | Loc. in Sec. |
|--------|-------|-----|-------|--------------------|
| Anh. | | | | |
| Tp. | | | | <u>SE NW NW</u> |
| H. | | | | |
| Tr. | | | | |
| Dg. | | | | |
| Bl. | | | | |
| L. | | | | Geol. |
| K.C. | | | | Contr. |
| B.K.C. | | | | <u>Wrico Drlg.</u> |
| Ce. | | | | |
| C. | | | | Pool |
| M. | | | | <u>Cabin Valle</u> |
| M. | | | | |
| K. | | | | |
| Mz. | | | | |
| Ma. | | | | |
| V. | | | | |
| S. | | | | |
| S. | | | | |
| A. | | | | |
| R. | | | | |
| Pe. | | | | |
| G. | | | | |
| T.D. | | | | |

FIRST REFC

Date Comm. 3-4-57

~~30~~