


Map No. **KANSAS** Sec. 12 Twp. 34 R. 6^EWell No. 1- Adams FarmTrees Oil Co Company

NORTH

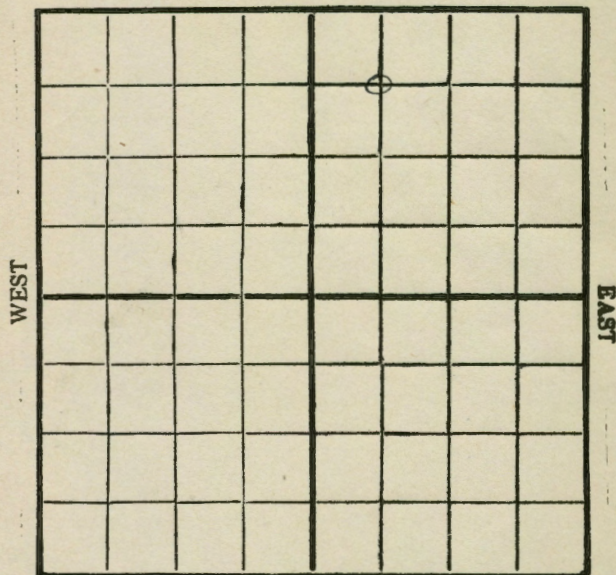

SOUTH

Location _____
Drilling Remarks _____Rig Up _____
Drilling Remarks _____

RECORD

Cased _____ in. _____ ft.
 Sand _____
 Gas _____
 Oil _____
 Total Depth _____

PRODUCTION

1st 24 hrs. Nat. _____
 1st 24 hrs. after shot _____
 Gas _____ cu. ft. _____
 Dry Hole _____
 Abandoned _____


Map No. **KANSAS** Sec. 12 Twp. 34 R. 6^EWell No. 1- Adams FarmTrees Oil Co Company

NORTH

660 Ft. from N. Line

_____ Ft. from S. Line

_____ Ft. from E. Line

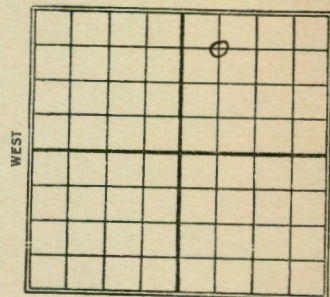660 Ft. from W. Line

SOUTH

Date 1929

REPORT

8/28 Spdg 60'
9/14 Drly 680'
9/11 sand 1062-86'
T.D. 1086'
4 1/4 gas
Pump.

Cowley

2 Map No. **KANSAS** Sec. 12 Twp. 34 R. 6Well No. 1 Adams
J. J. Co Company
Contractor**COMPLETE**

SECTION PLAT

660 Ft. from N. Line
Ft. from S. Line
Ft. from E. Line
660 Ft. from W. Line

		0	

Location

Rig up

Drilling and Remarks:

gas well.

RECORD

Cased in. ft.

Sand 1062-1086

Gas

Oil

Total Depth 1086

PRODUCTION

1st 24 hrs. Nat.

1st 24 hrs. after shot

Gas 4 Cu. Ft.

Dry Hole

Abandoned

Date

SEP 11 1929

19

CHAS. L. SHERWOOD

Scout

Cowley

2 Map No. **KANSAS** Sec. 12 Twp. 34 R. 6^EWell No. 1 Adams
J. J. Co Company
Contractor**FIRST REPORTS**

SECTION PLAT

660 Ft. from N. Line
Ft. from S. Line
Ft. from E. Line
660 Ft. from W. Line

		0	

Location

Rig up

Drilling and Remarks:

Mch.
Spdy 60'

RECORD

Cased in. ft.

Sand

Gas

Oil

Total Depth

PRODUCTION

1st 24 hrs. Nat.

1st 24 hrs. after shot

Gas Cu. Ft.

Dry Hole

Abandoned

Date

AUG 28 1929

19

CHAS. L. SHERWOOD

Scout